SITE PLAN
FOR
ANTHONY CAMPOFREDANO
BEING KNOWN AS A PART OF LOT No. 11, PAINE TRACT,
IN MADISON TOWNSHIP, LAKE COUNTY, OHIO.

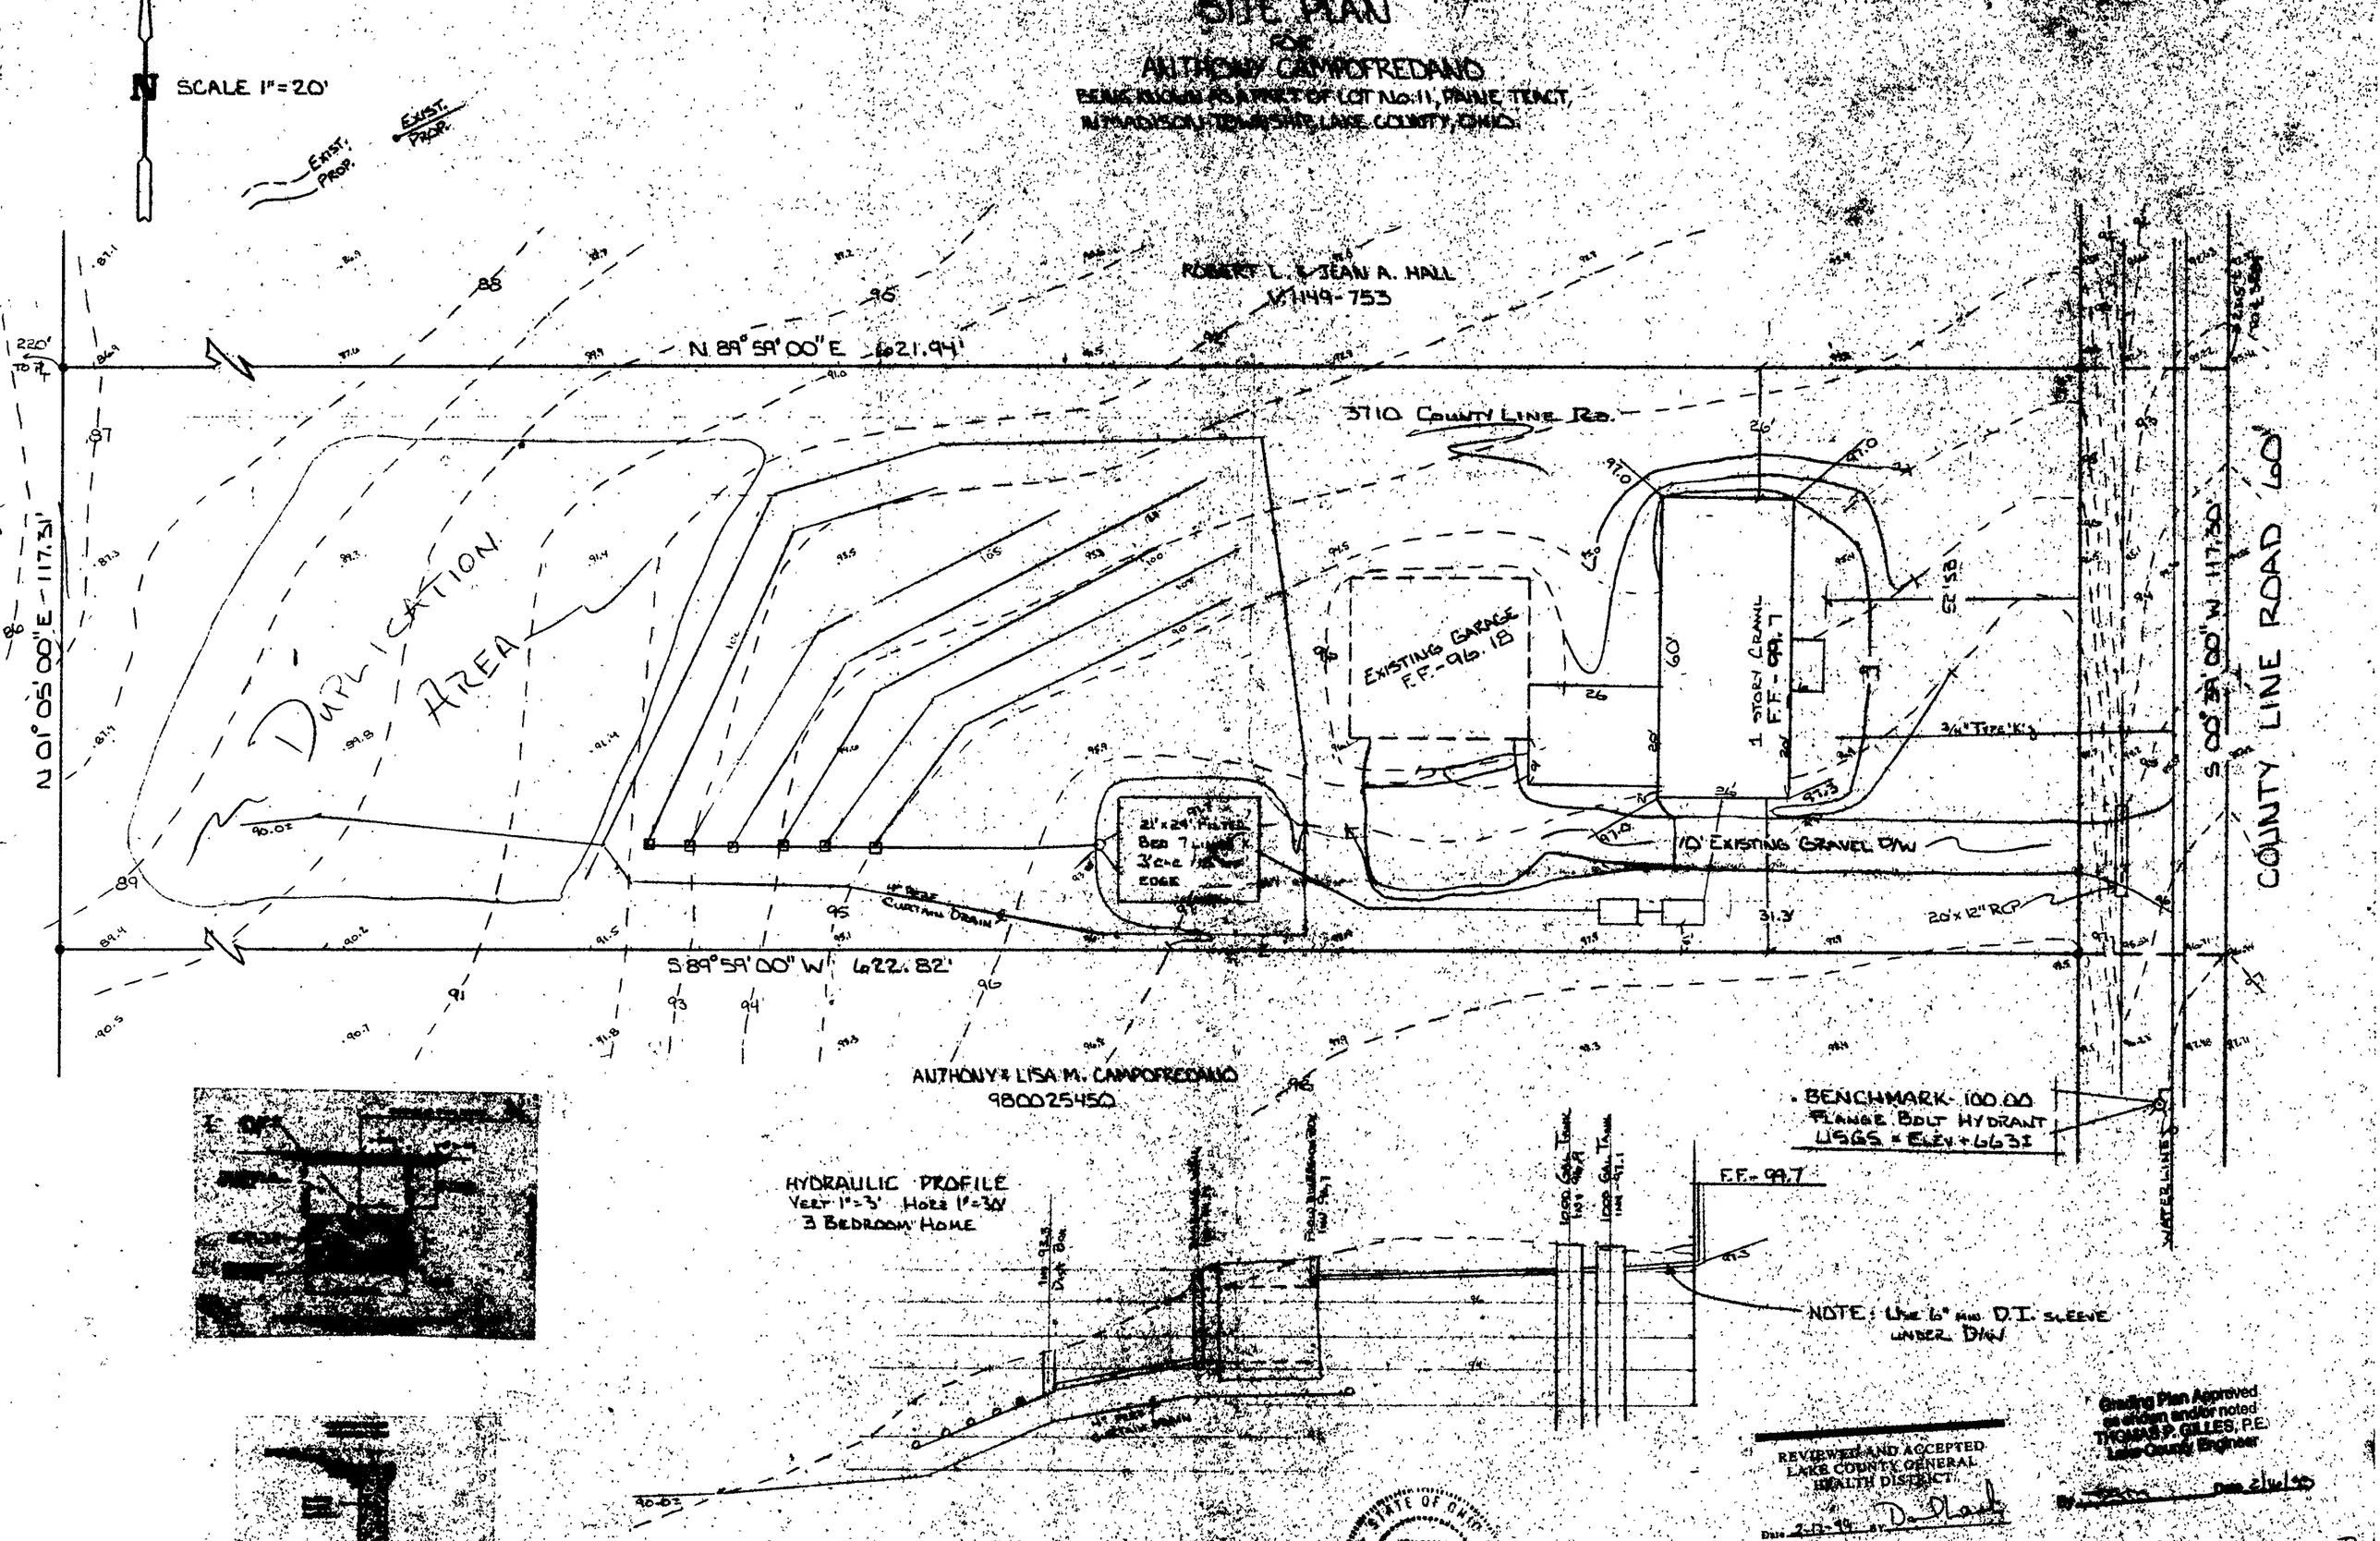

 

REVIEWED AND ACCEPTED
LAKE COUNTY GENERAL
HEALTH DISTRICT
Date 2-17-99 BY [signature]

SEWAGE DISPOSAL PERMIT MUST BE OBTAINED BY A LAKE COUNTY LICENSED INSTALLER BEFORE INSTALLATION IS STARTED.

Grading Plan Approved as shown and/or noted
THOMAS P. GILLES, P.E.
Lake County Engineer
By [signature] Date 2/16/99

APPROVED
MADISON TOWNSHIP ZONING
DATE [illegible] Subject to OCND approval
BY [signature]

STATE OF OHIO
THOMAS NASO COFFMAN
PROFESSIONAL ENGINEER

Nov 10, 1998
Rev Feb 1, 1999

[signature]