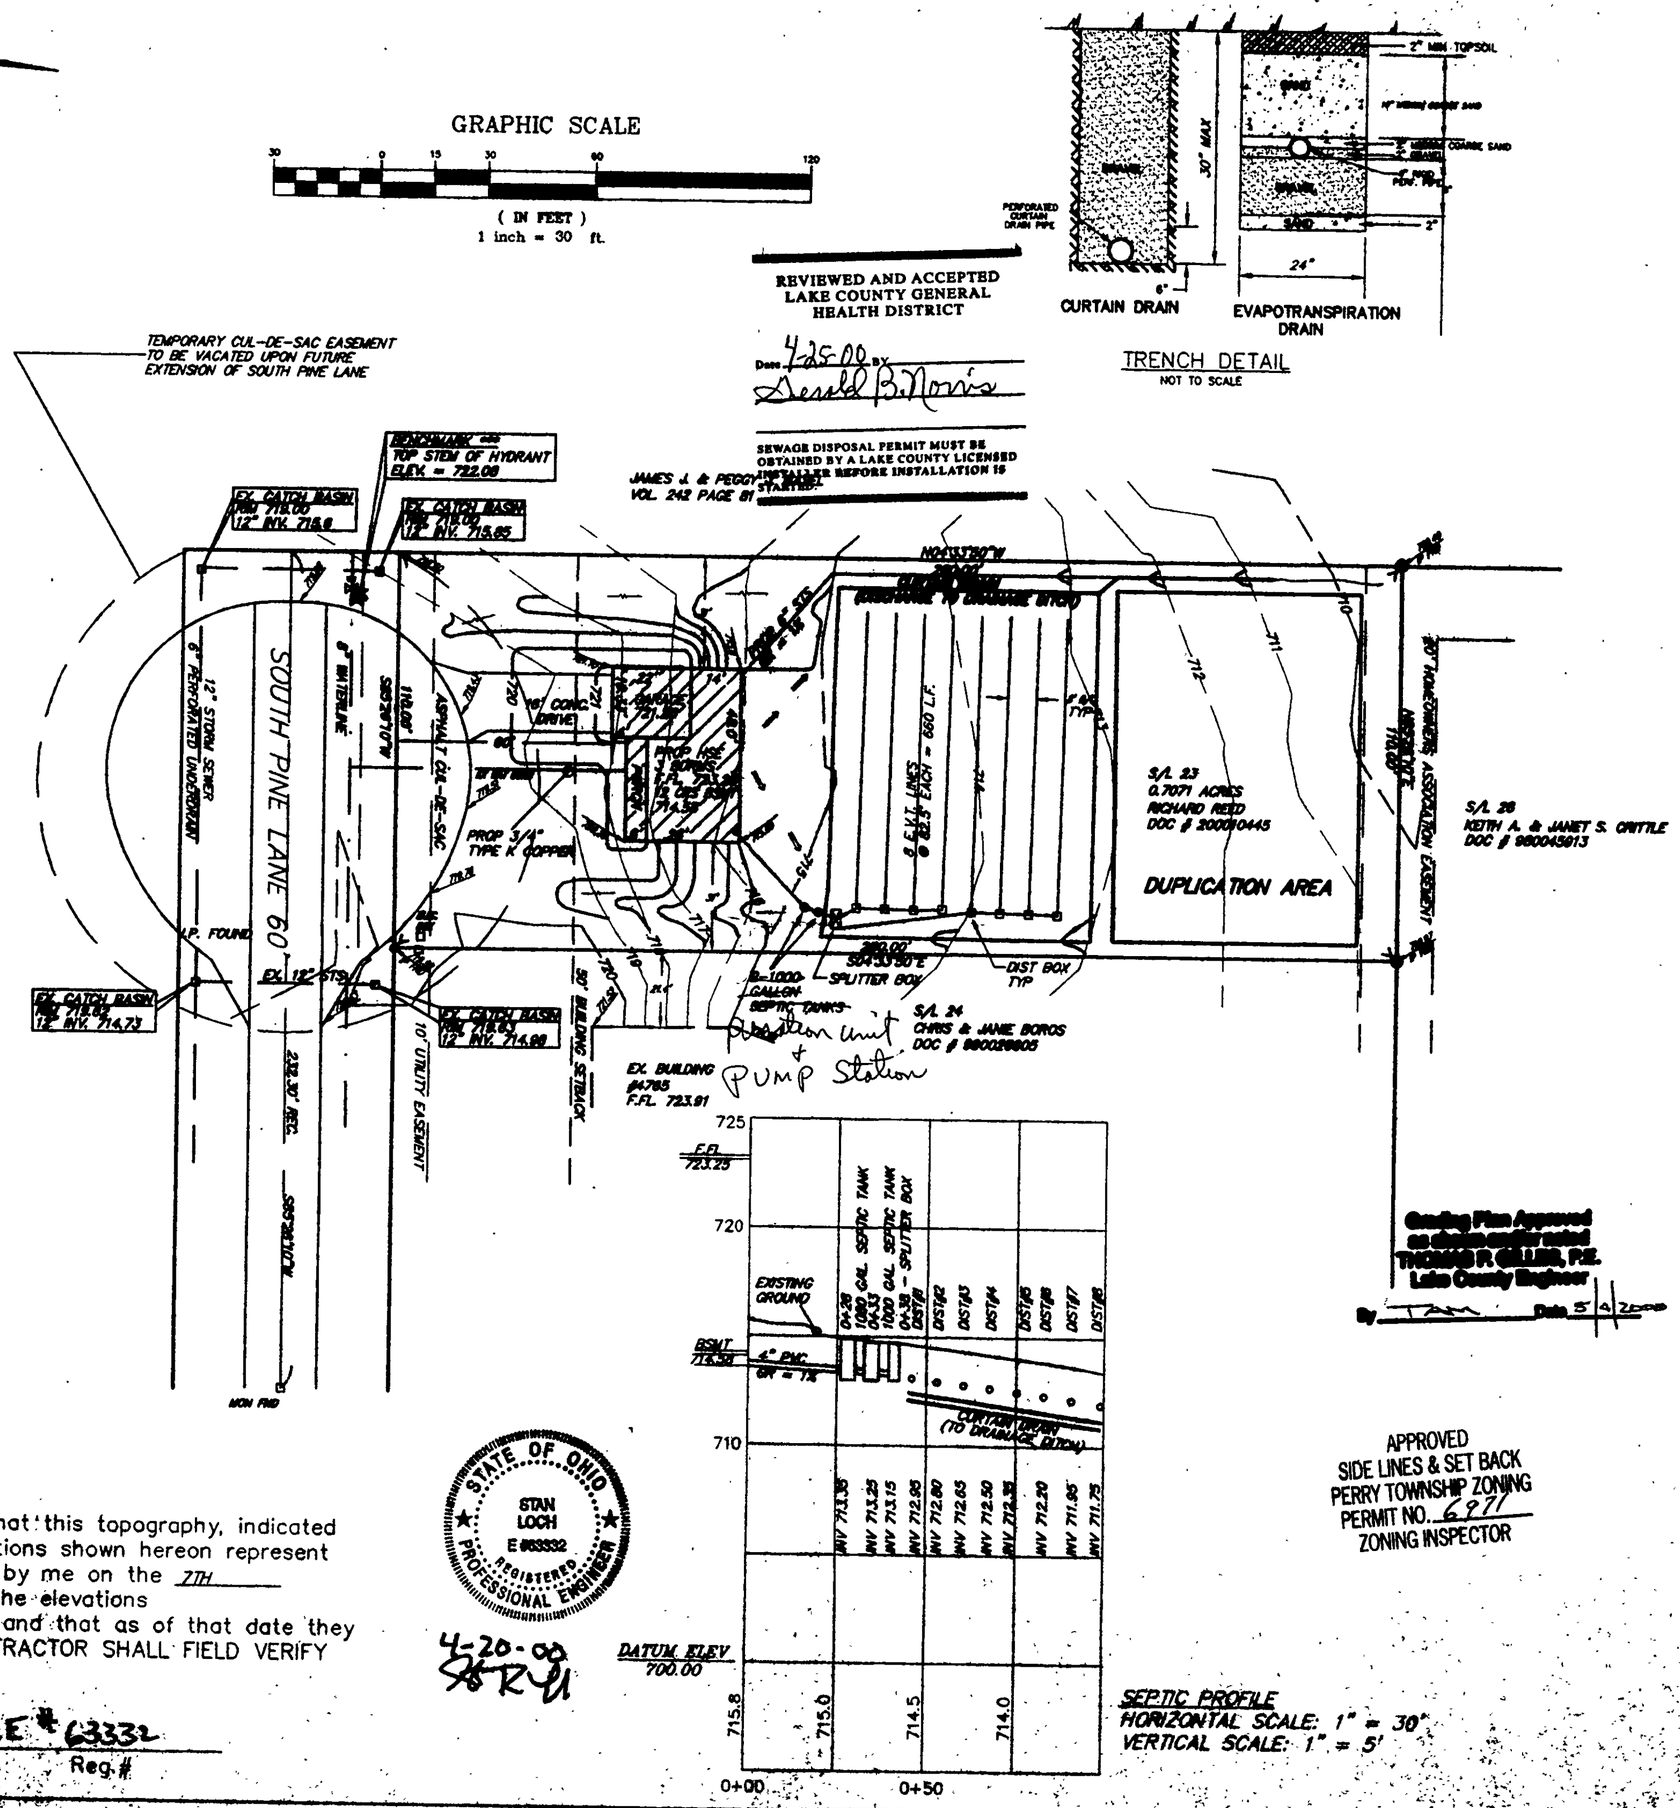

TRENCH DETAIL
NOT TO SCALE

REVIEWED AND ACCEPTED
LAKE COUNTY GENERAL
HEALTH DISTRICT

Date 4-25-00 BY Gerald B. Norris

SEWAGE DISPOSAL PERMIT MUST BE OBTAINED BY A LAKE COUNTY LICENSED INSTALLER BEFORE INSTALLATION IS STARTED.

"I, the undersigned hereby certify that this topography, indicated by 6" 1' or 2' contours, and elevations shown hereon represent an actual survey field survey made by me on the 7TH day of APRIL, 20 00 and that the elevations were taken at appropriate intervals and that as of that date they existed as indicated hereon." CONTRACTOR SHALL FIELD VERIFY ALL MEASUREMENTS.

Name

P.E # 63332
Reg. #

SITE PLAN FOR:
R.C. REED BUILDERS
BEING S/L 23 OF THE SOUTH
PERRY PINES SUBDIVISION
TOWNSHIP OF PERRY
COUNTY OF LAKE
STATE OF OHIO

NO. DATE DESCRIPTION BY

5794 HERBERT ROAD MENTOR OHIO 44060
440-639-9950
FAX 639-9790

ENGINEERING and SURVEYING
Civil Engineering Land Surveying

VERT. SCALE: 1" = 5'
DATE: 4/10/2000
DRAWING NO.
SHEET 1 OF 1