



REVIEWED AND ACCEPTED
LAKE COUNTY GENERAL
HEALTH DISTRICT
Date 4-30-03
By David B. Norris
WASTE DISPOSAL PERMIT MUST BE
OBTAINED BY A LAKE COUNTY LICENSED
INSTALLER BEFORE INSTALLATION IS
STARTED


NOTE: ALL IRON PINS SET ARE
5/8" X 30" AND ARE CAPPED
BABCOCK JONES & ASSOC.

Grading Plan Approved
as shown and/or noted
JAMES R. GILLS, P.E.
Lake County Engineer
By DMJ Date 6/2/03



3A-45-1&2

3A-42D-3

3A-42D-4

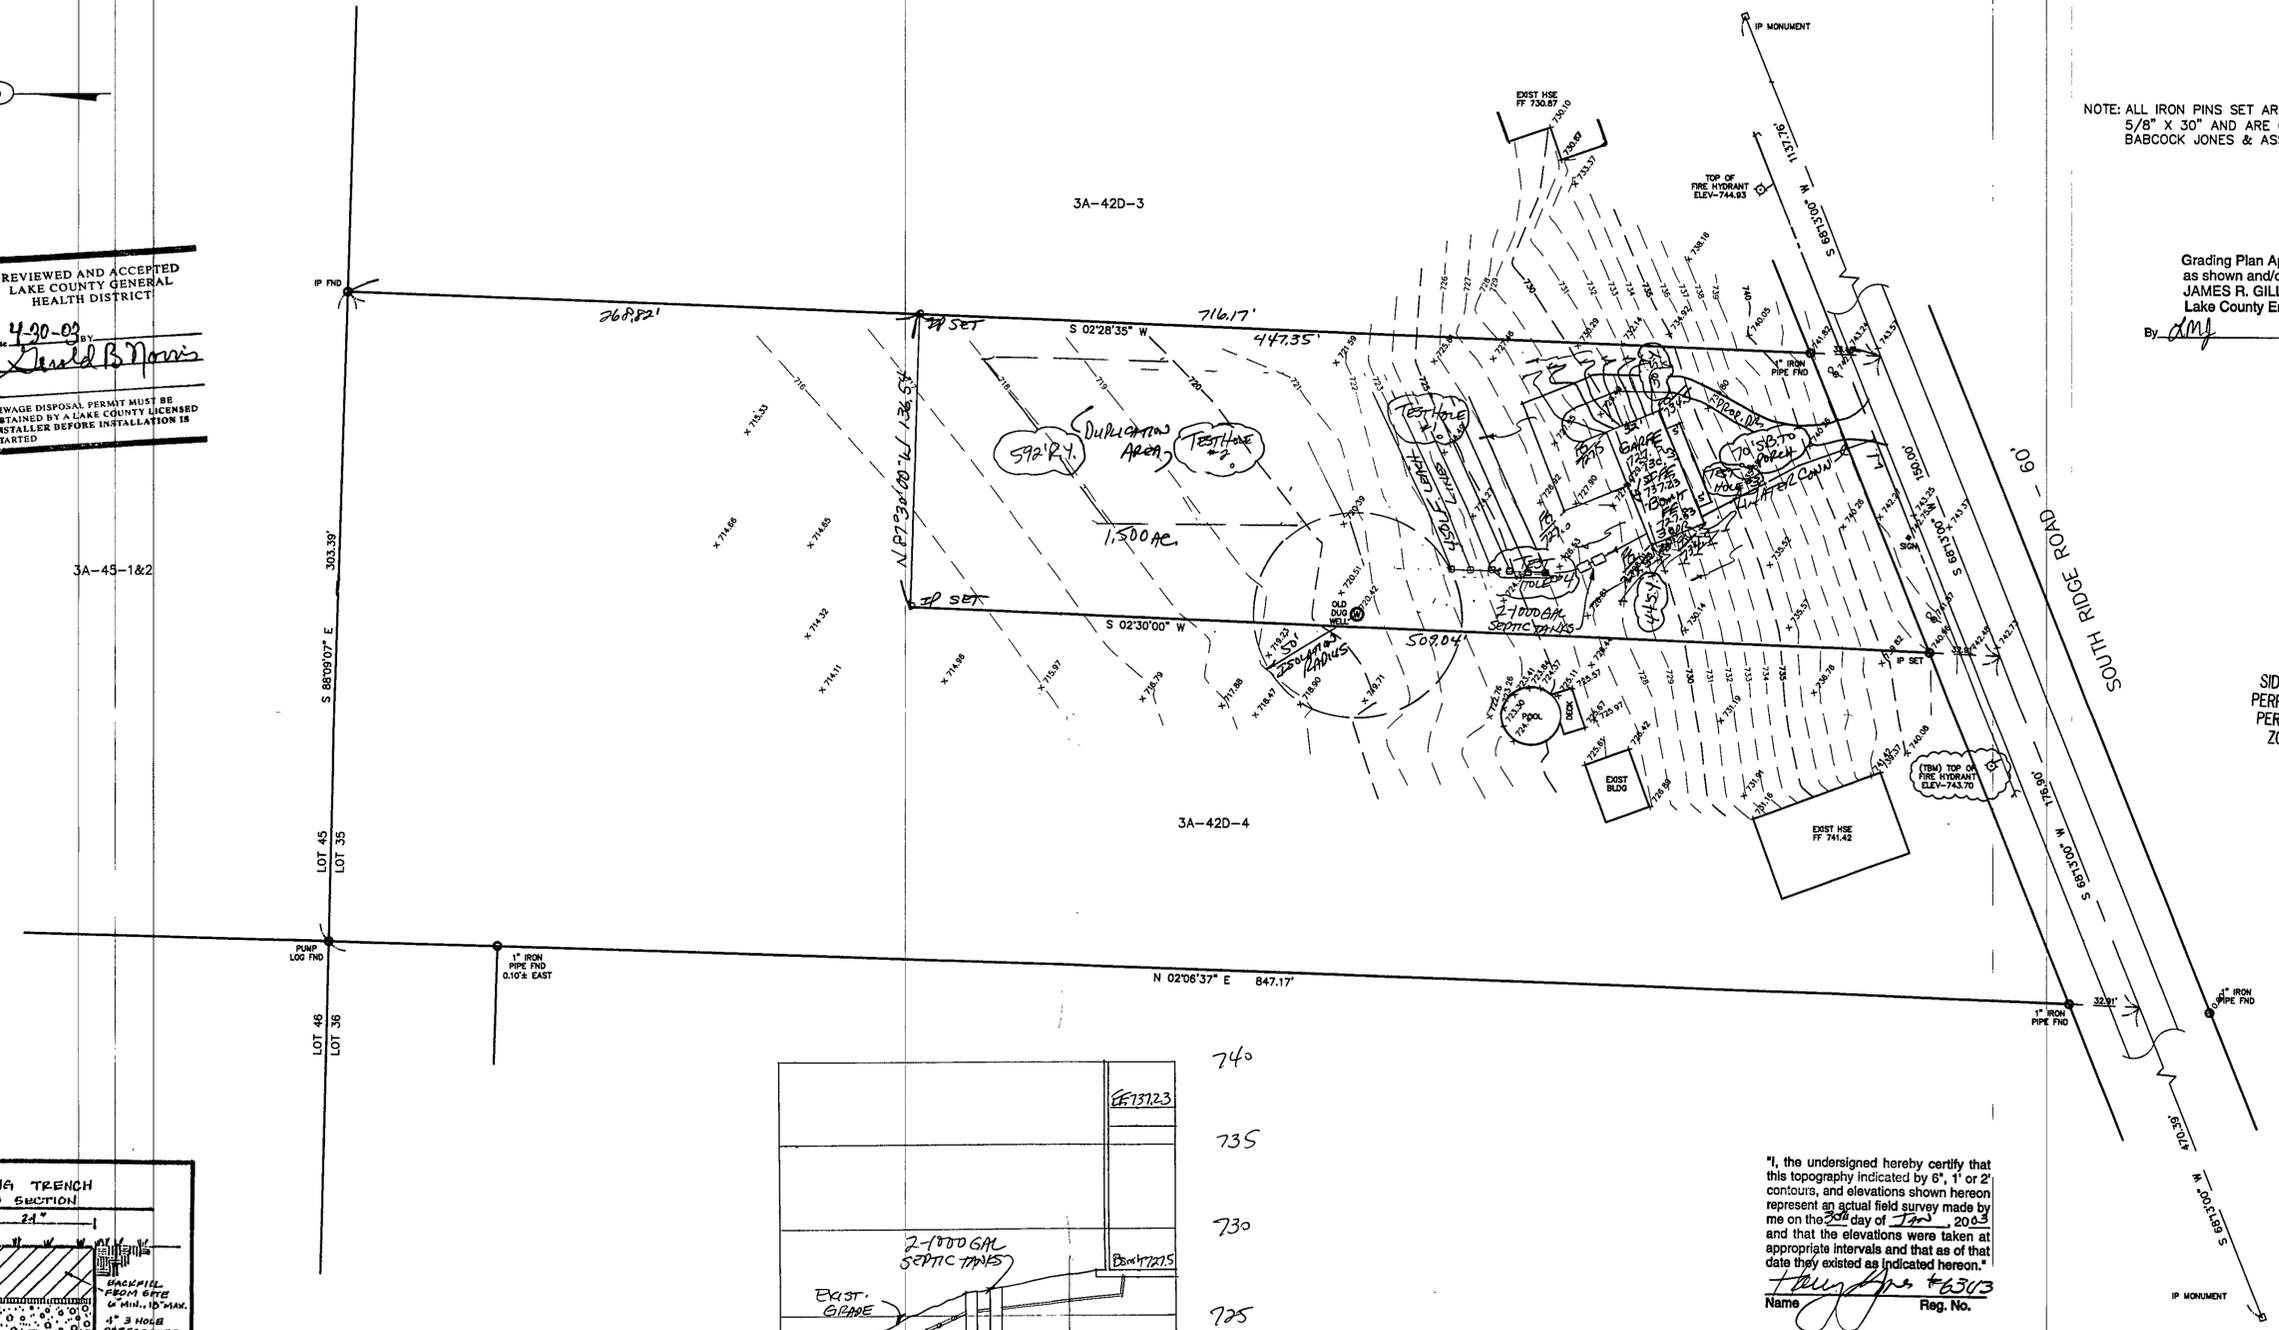

APPROVED
SIDE LINES & SET BACK
PERRY TOWNSHIP ZONING
PERMIT NO. 2866
ZONING INSPECTOR

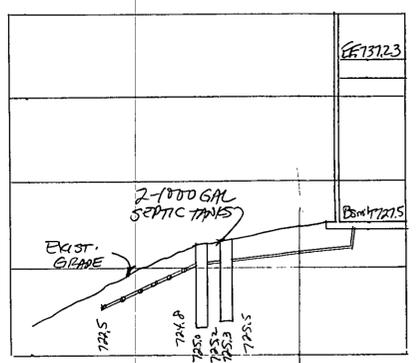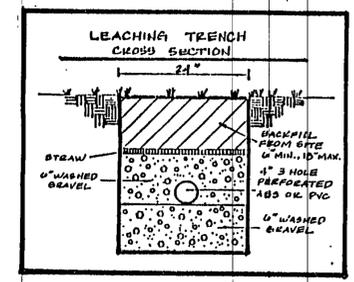

HYDRAULIC PROFILE
HORIZ: 1"=40' VERT: 1"=5'

"I, the undersigned hereby certify that this topography indicated by 6", 1' or 2' contours, and elevations shown hereon represent an actual field survey made by me on the 20th day of Jan, 2003 and that the elevations were taken at appropriate intervals and that as of that date they existed as indicated hereon."
Name: [Signature] Reg. No. 6503

TBM - TOP OF WESTERLY
FIRE HYDRANT
ELEV - 743.70

EXISTING UTILITIES NOTE:
THE SIZE AND LOCATION, BOTH HORIZONTAL AND VERTICAL OF THE UNDERGROUND UTILITIES SHOWN HEREON, HAVE BEEN OBTAINED BY A SEARCH OF AVAILABLE RECORDS. VERIFICATION BY FIELD OBSERVATION HAS BEEN CONDUCTED WHERE PRACTICAL. HOWEVER, BABCOCK JONES AND ASSOCIATES, INC. DOES NOT GUARANTEE THE COMPLETENESS NOR ACCURACY THEREOF.



REV. NO.	DESCRIPTION	DATE	BY	CHKD
1	REVISED LOT SIZE	2/10/03	HJ	HJ
2	REVISED HOUSE DIMENSIONS	2/27/03	HJ	HJ
3	REVISIONS PER LAKE COUNTY HEALTH DIST.	4/24/03	HJ	HJ

bj BABCOCK, JONES AND ASSOCIATES, INC
CIVIL ENGINEERS - SURVEYORS - LAND PLANNERS
PAINESVILLE OHIO 44077

DATE 1/31/03
DESIGN BY H.J.
DRAWN BY B.P.
APPROVED BY H.J.

SITE PLAN
FOR
BETSY FLEMING
3951 SOUTH RIDGE ROAD
LAKE COUNTY STATE OF OHIO

SCALE 1"=40'
JOB NO 03-010
SHEET 1 OF 1