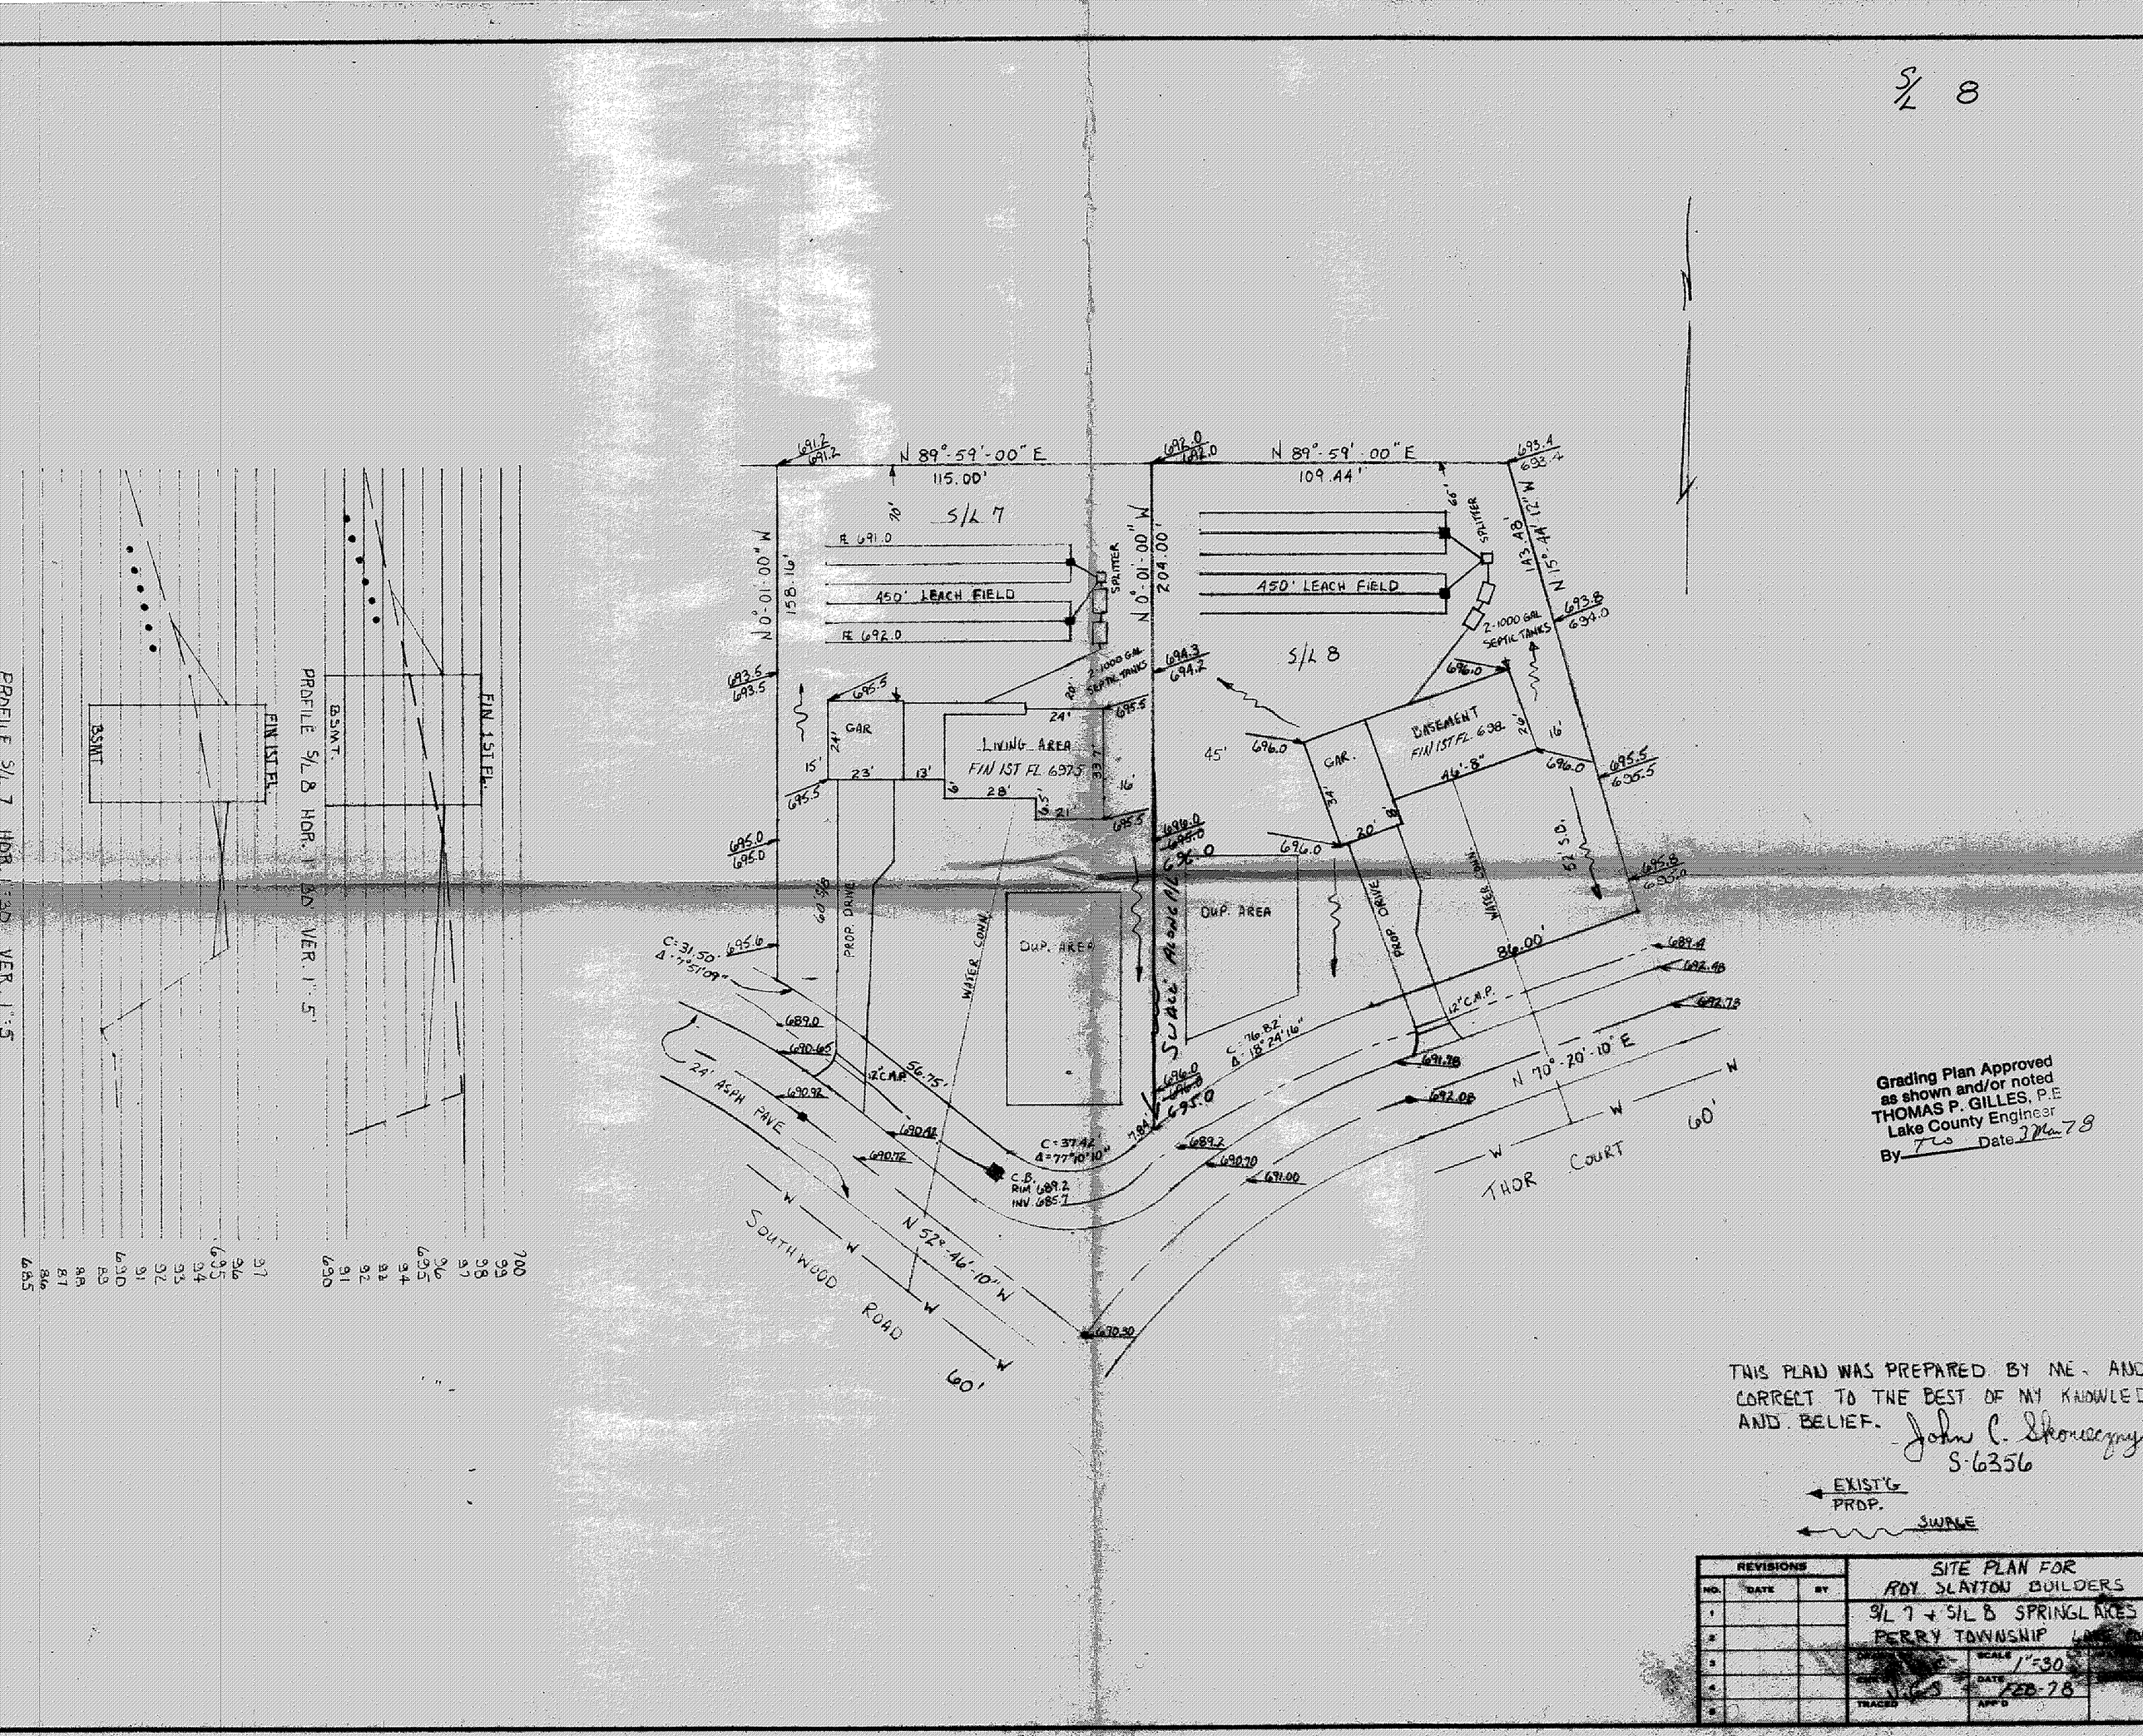

Grading Plan Approved as shown and/or noted
THOMAS P. GILLES, P.E
Lake County Engineer
By TCO Date 3 Mar 78

THIS PLAN WAS PREPARED BY ME, AND CORRECT TO THE BEST OF MY KNOWLED AND BELIEF. John C. Skoniecznyj S-6356

EXIST'G
PROP.
SWALE

REVISIONS			SITE PLAN FOR ROY SLAYTON BUILDERS
NO.	DATE	BY	S/L 7 + S/L 8 SPRINGLAKES PERRY TOWNSHIP LAKE
1			SCALE 1"=30'
2			DATE FEB-78
3			TRACED / APP'D
4			
5			

WNE POST 18AE-15E-18X24