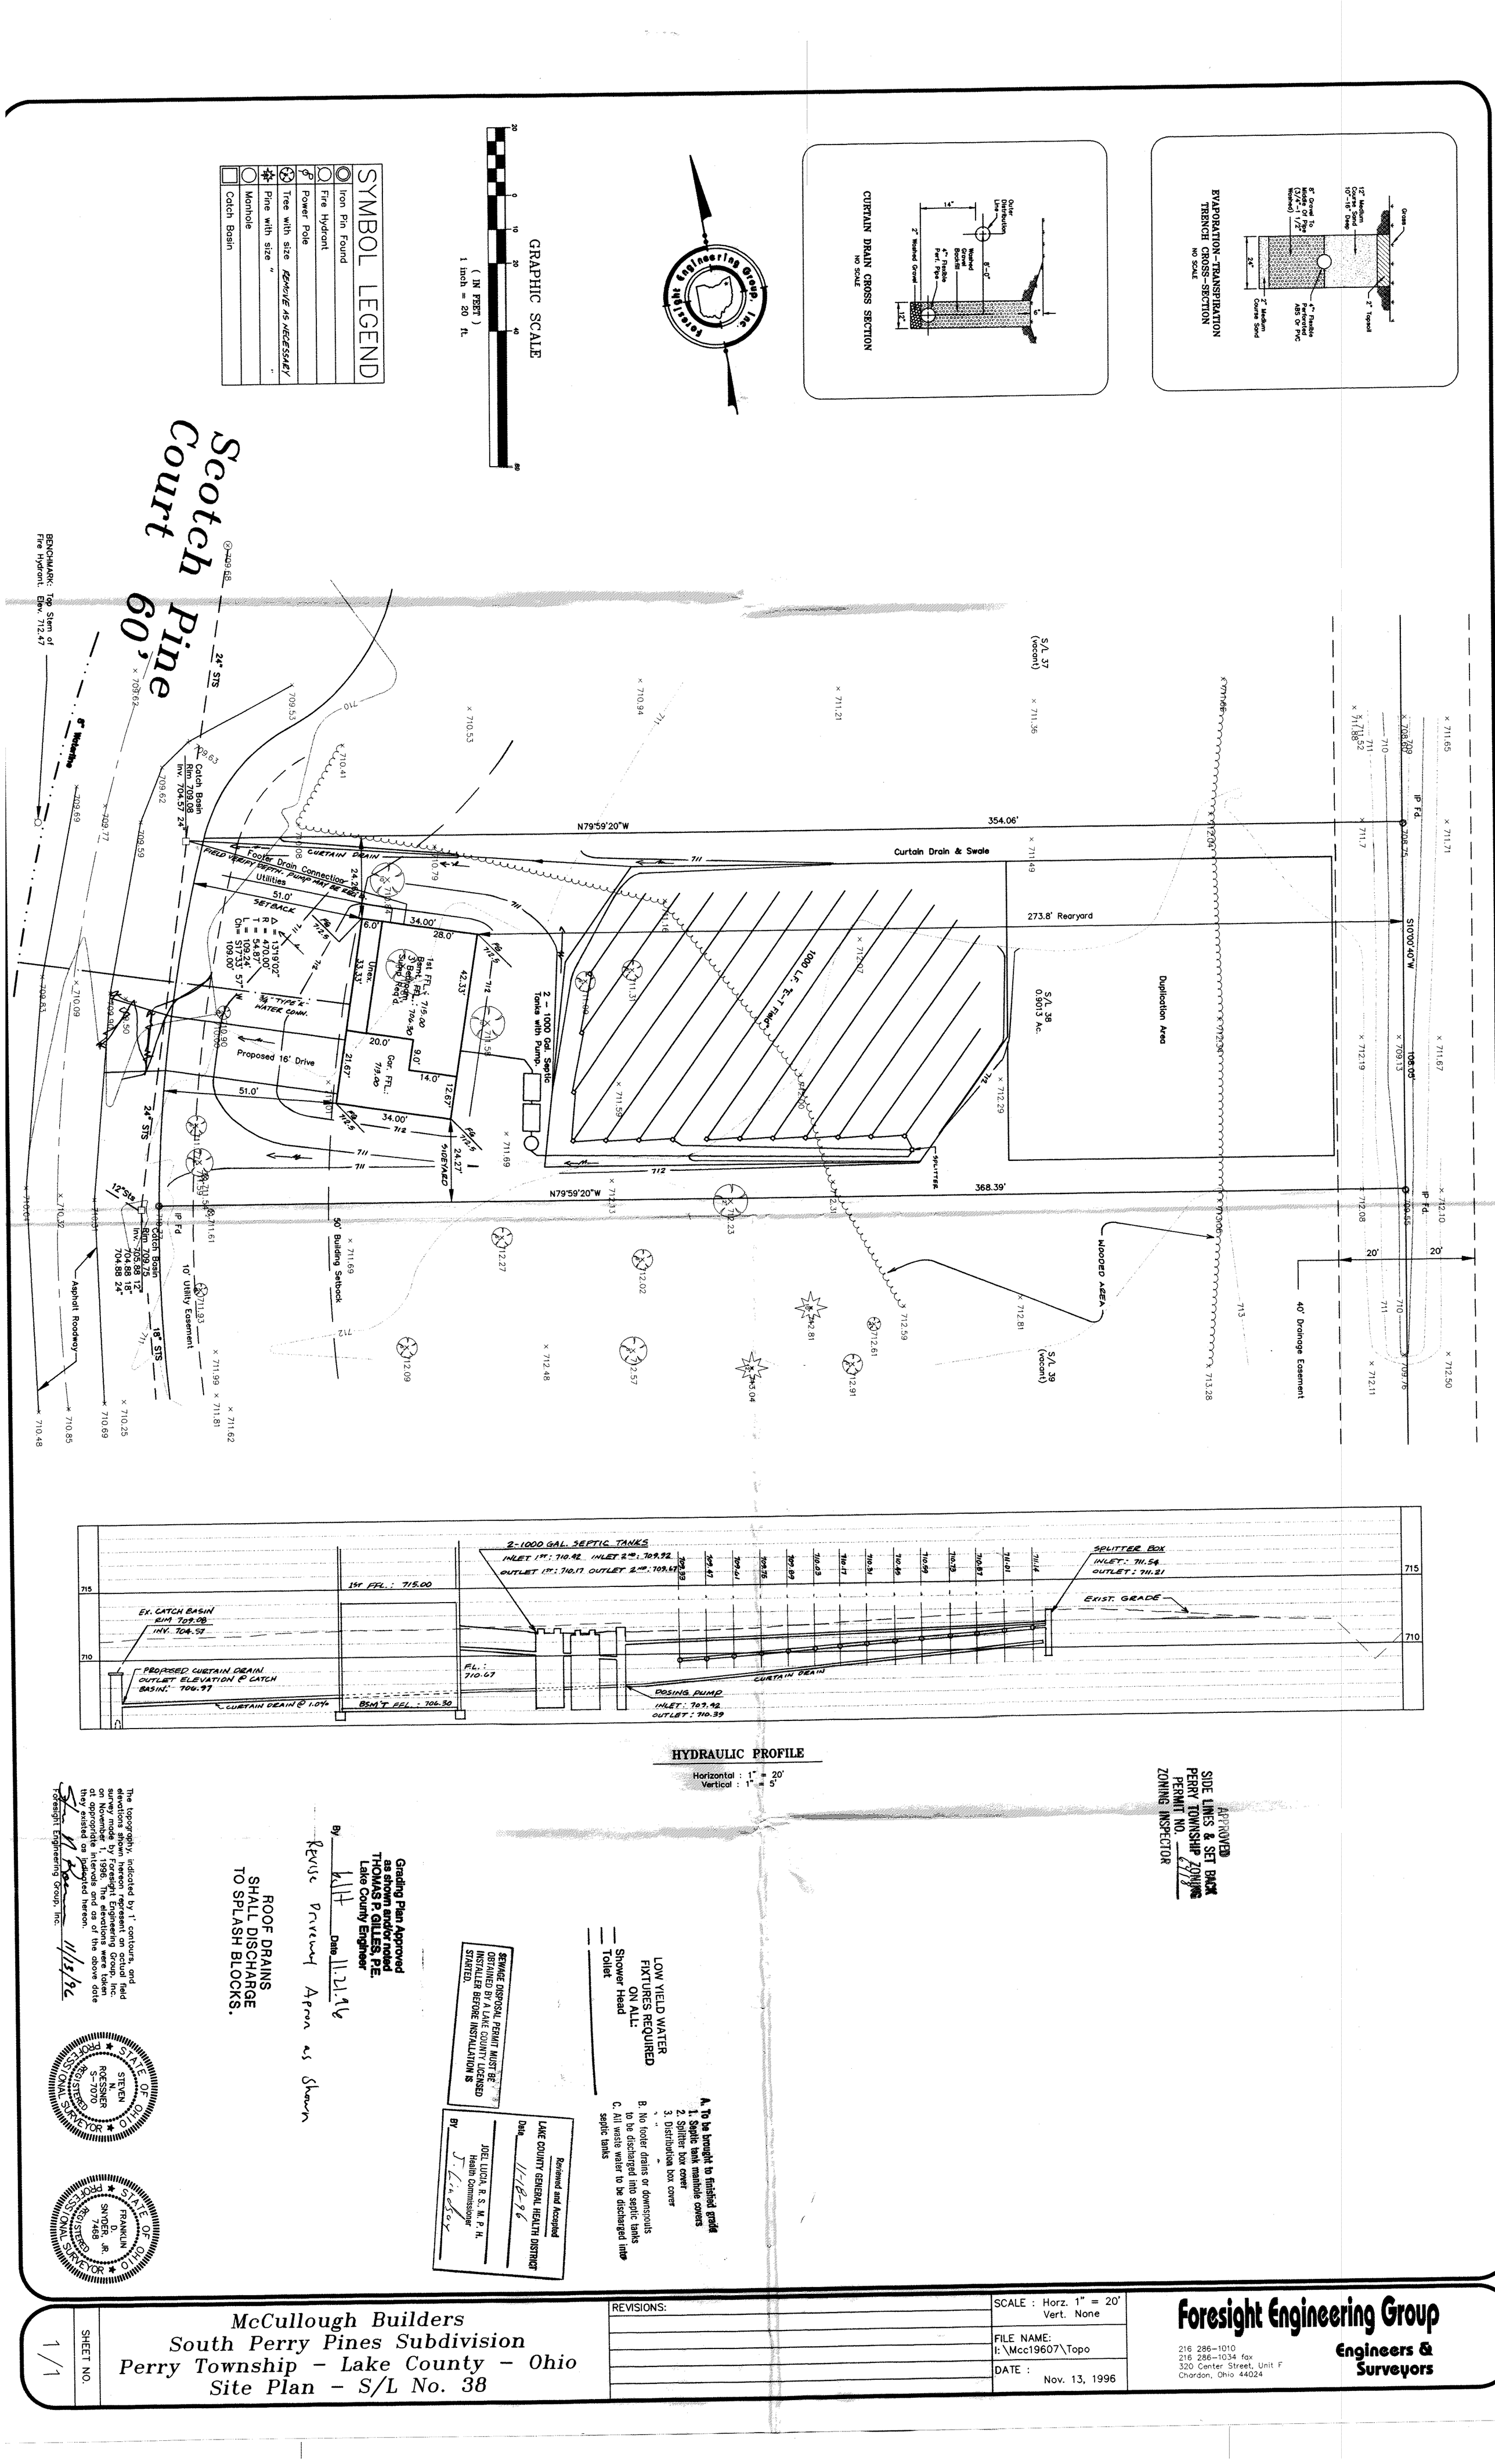

McCullough Builders
South Perry Pines Subdivision
Perry Township - Lake County - Ohio
Site Plan - S/L No. 38

SHEET NO. 1/1

REVISIONS:

SCALE : Horz. 1" = 20'
Vert. None

FILE NAME: I:\Mcc19607\Topo

DATE : Nov. 13, 1996

Foresight Engineering Group
Engineers & Surveyors
216 286-1010
216 286-1034 fax
320 Center Street, Unit F
Chardon, Ohio 44024