SCALE: 1" = 20'

# SITE PLAN
FOR
# TOM REED
BEING A PART OF ORIGINAL LOT NO. 47 IN
PERRY TOWNSHIP, LAKE COUNTY, OHIO.

PERRY OH

TOM REED
1350 MADISON AVE
PAINESVILLE
352-4805

EXIST PROP

EXIST PROP

FF-100.7

1000 GAL TANK INV 94.7

1000 GAL TANK INV 94.4

SPLITTER INV 96.5

DIST BOX (2) INV 96.7

GRINDER PUMP REQ. IF PLUMBING IN BSMT.

BSMT-92.03

3 BEDROOM HOME
HYDRAULIC PROFILE
VERT: 1" = 3' HORZ 1" = 30'

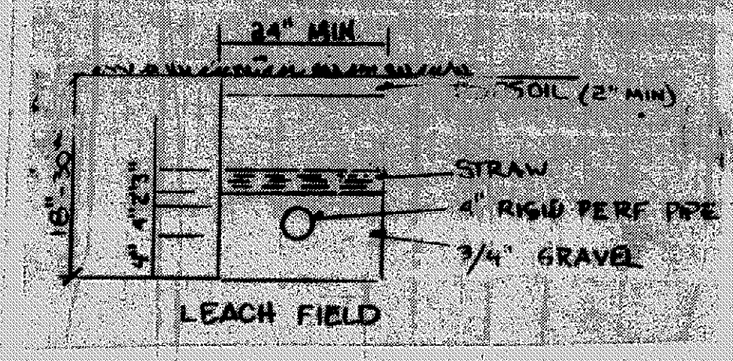


APPROVED
SIDE LINES & SET BACK
PERRY TOWNSHIP ZONING
PERMIT NO. 6237
ZONING INSPECTOR

DAVID & BETTY WEST
VOL 160 81

S 00° 10' 31" W 927.14'

N 75° 29' 20" E 119.59'

EXISTING FENCE

EXISTING BARN

30'

24'

50'

42'

F.F. 100.7
BSMT - 92.03

24'

4'

18'

BLAB - 100.03
20'

GAR - 98.7

20'

24'

CONC APRON

PROP WELL

100.7

98.6

98.8

98.7

98.5

98.4

98

97

5 LEACH @ 100' EA

3' MIN

DUPLICATION AREA

Grading Plan Approved
as shown and/or noted
THOMAS P. GILLES, P.E.
Lake County Engineer
By GJH Date 1-31-96

S 89° 24' 47" W 160.00'

48'

60'

SHEPARD ROAD

12" MIN. CULVERT

GOOD TO ELIMINATE

40' GRAVEL R/W

N 00° 10' 31" E 887.34'

SEWAGE DISPOSAL PERMIT MUST BE OBTAINED BY A LAKE COUNTY LICENSED INSTALLER BEFORE INSTALLATION IS STARTED.

H. LAKELY & SON
V 547-1122

LOW YIELD WATER FIXTURES REQUIRED ON ALL:
___ Shower Head
___ Toilet

A. To be brought to finished grade
1. Septic tank manhole covers
2. Splitter box cover
3. Distribution box cover
B. No footer drains or downspouts to be discharged into septic tanks
C. All waste water to be discharged into septic tanks

Reviewed and Accepted
LAKE COUNTY GENERAL HEALTH DISTRICT
Date 1-23-96
JOEL LUCIA, R.S., M.P.H.
Health Commissioner
BY J. Lucia

BENCHMARK - 100.00
NAIL IN POWER POLE

STATE OF OHIO
THOMAS
GILLES
DEC 15, 1995

I, the undersigned hereby certify this topography, indicated by 1' contours, and elevations shown hereon represent an actual field survey by me on Dec 1, 1995 and that the were taken at appropriate intervals and that as of that date they existed as indicated hereon.

T. M. Gilles PE

**VILLAGE SURVEYING CO**
**P.O. BOX 1096, FAIRPORT HARBOR, OHIO 44077**
(216) 357-1358