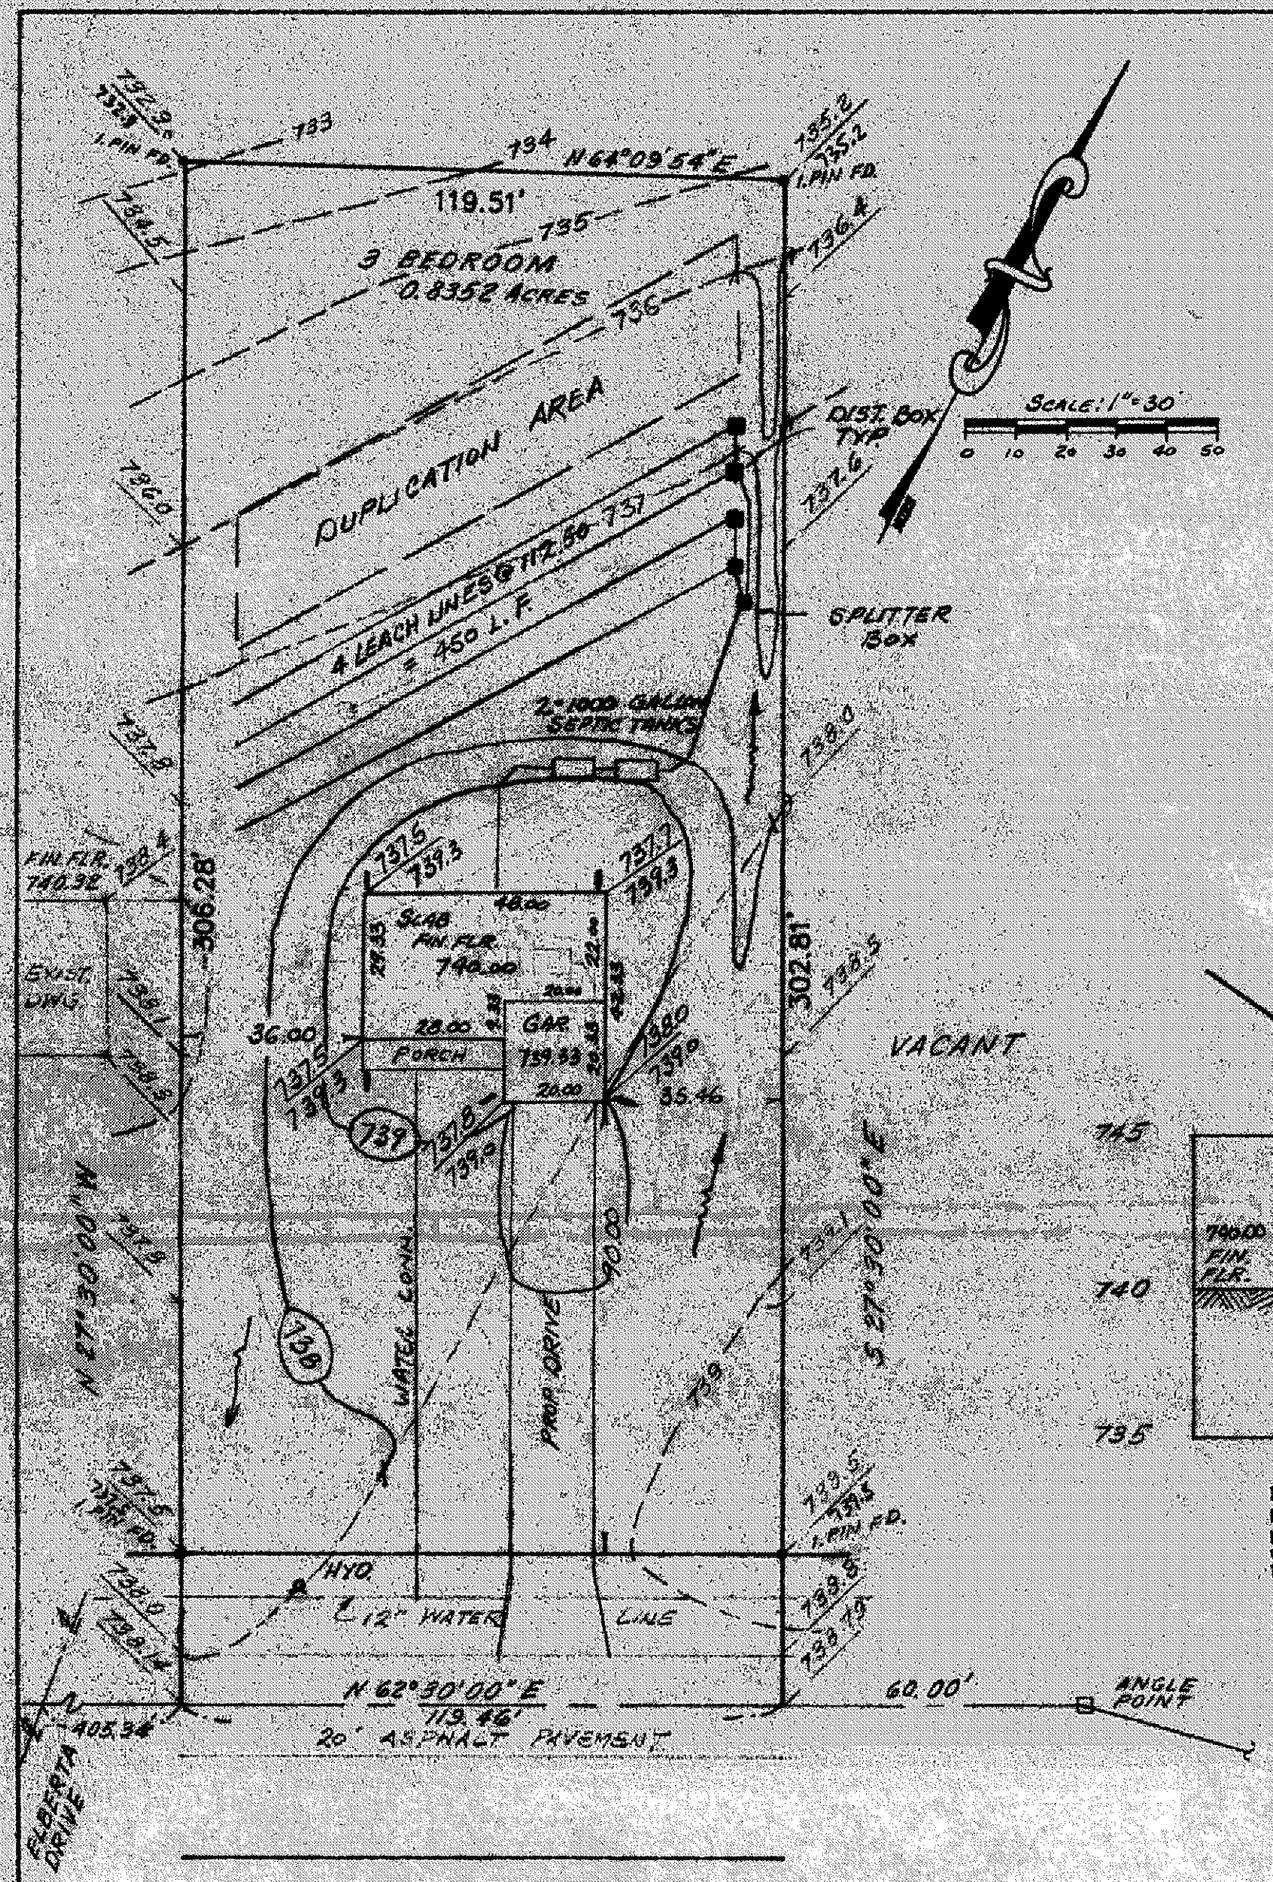

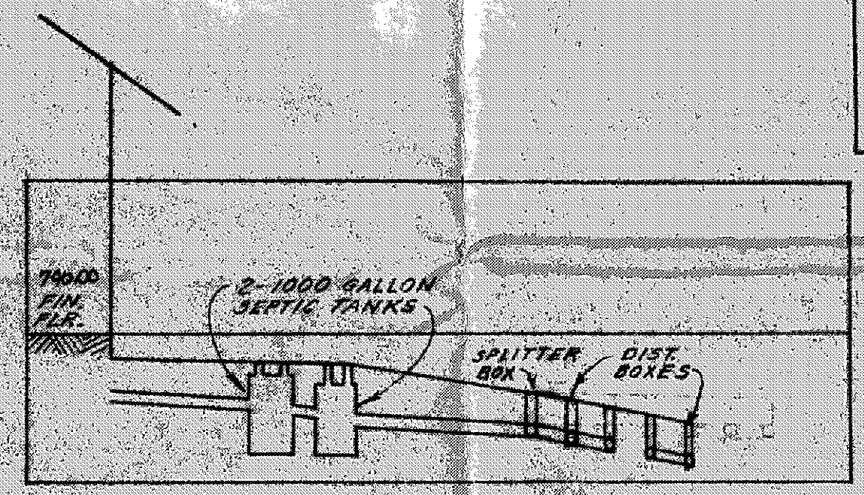

HYDRAULIC PROFILE

SCALE: HOR: 1"=30'
VER: 1"=5'

SEWAGE DISPOSAL PERMIT MUST BE OBTAINED BY A LAKE COUNTY LICENSED INSTALLER BEFORE INSTALLATION IS STARTED.

LOW YIELD WATER FIXTURES REQUIRED ON ALL:
___ Shower Head
___ Toilet
___ _____

A. To be brought to finished grade
1. Septic tank manhole covers
2. Splitter box cover
3. Distribution box cover
" " "
B. No footer drains or downspouts to be discharged into septic tanks
C. All waste water to be discharged into septic tanks

Reviewed and Accepted
LAKE COUNTY GENERAL HEALTH DISTRICT
Date May 3, 1993
JOEL LUCIA, R. S., M. P. H.
Health Commissioner
BY Nancy Nuemo

SITE PLAN

for: ANGELORO CONSTRUCTION
4304 MAPLE ST. PERRY
ADDRESS STREET CITY

SUBLOT No.	SUBDIVISION NAME	VOL. PAGE
5		
43	PERRY	OHIO
LOT, TRACT	TOWNSHIP	

THE NORTH COAST ENGINEERING AND SURVEYING CO., INC.
2570 SUPERIOR AVE., SUITE 501
CLEVELAND, OHIO 44114
TEL. (216) 241-7070 FAX (216) 241-7071

CHECK LIST

LOT DIMENSIONS & BEARINGS
TIE TO NEAREST STREET
SUBLOT No. (PARCEL No.)
SURROUNDING OWNERS
BUILDING DIMENSIONS
SETBACK, SIDEYARD, REARYARD
FINISHED GRADES
DRIVE & APRON TYPE, WDTH, THICKNESS
SIDEWALK TYPE, WIDTH, THICKNESS
CULVERT TYPE, DIAM., LENGTH
WATER MAIN SIZE, LOCATION
SAN. SEWER SIZE, % GRADE, LOCATION
SAN. M.H. CAST. ELEV., INV. ELEV.
SAN. CONN. SIZE, % GRADE, LOCATION
STORM SEWER SIZE, % GRADE, LOCATION
STORM M.H. CAST. ELEV., INV. ELEV.
PAVT. TYPE, GRADE, CURBS
GAS LINE LOC. SIZE
SEPTIC SYSTEM & DUPLICATION
WELL LOCATION & ISOLATION RADIUS

STATE OF OHIO JOSEPH GUTOSKEY 51801 REGISTERED SURVEYOR
STATE SEAL

DESIGN CERTIFICATION

THIS PLAT WAS PREPARED BY ME, AND IS CORRECT TO THE BEST OF MY KNOWLEDGE.
Joseph Gutoskey PE 4/20/93
NAME DATE

"AS-BUILT" CERTIFICATION

I HEREBY CERTIFY THAT THE CIRCLED INFORMATION IS EXISTING AS OBTAINED ON THE SITE _____ 19___ AND IS CORRECT TO THE BEST OF MY KNOWLEDGE AND BELIEF.

NAME

LEGEND

STORM MANHOLE
SANITARY MANHOLE
EXISTING CONTOURS ----100----
PROPOSED CONTOURS ——(100)——
EXIST. ELEV. 100.0
100.0 PROP. ELEV.
DIRECTION OF SURFACE DRAINAGE

DRAWN BY	SCALE
FW.	1"=30'
CHK'D BY	DATE
JG	4-93
REV.	
REV.	
REV.	

BENCHMARK: T.B.M. - TOP NUT OF HYDRANT @ SUBLOT NO. 5 ELEV.= 740.32

"I, THE UNDERSIGNED HEREBY CERTIFY THAT THE TOPOGRAPHY SHOWN HEREON, INDICATED BY ONE FOOT CONTOURS AND ELEVATIONS REPRESENTS AN ACTUAL FIELD TOPOGRAPHIC SURVEY MADE BY ME ON THE 6th DAY OF April, 1993 AND THAT THE ELEVATIONS WERE TAKEN AT APPROPRIATE INTERVALS AND THAT AS OF THAT DATE THEY EXISTED AS INDICATED HEREON."

STATE OF OHIO EDWARD B. DUDLEY III 6747 REGISTERED SURVEYOR

EDWARD B. DUDLEY III REG. NO. 6747

TYPICAL LEACHING TRENCH CROSS SECTION

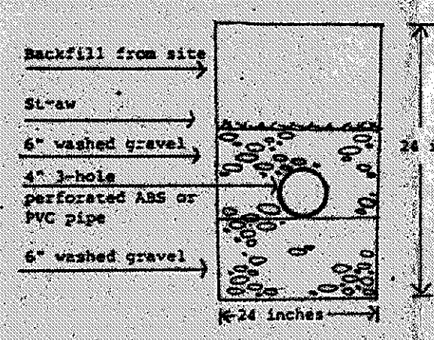

* The standard leaching trench is 24 inches deep, however the trench can vary between 18 to 30 inches depp if necessary. Gravel requirement is standard - amount of backfill would vary.

Grading Plan Approved as shown and/or noted
THOMAS P. GILLES, P.E.
Lake County Engineer
By GJH Date 5 5 93
ODOT PERMITS AS REQUIRED

APPROVED
SIDE LINES & SET BACK
PERRY TOWNSHIP ZONING
PERMIT NO. 4778
ZONING INSPECTOR Don Kin

2 WORKING DAYS BEFORE YOU DIG
CALL TOLL FREE 800-362-2764
OHIO UTILITIES PROTECTION SERVICE

CONTRACT NO. 93-165