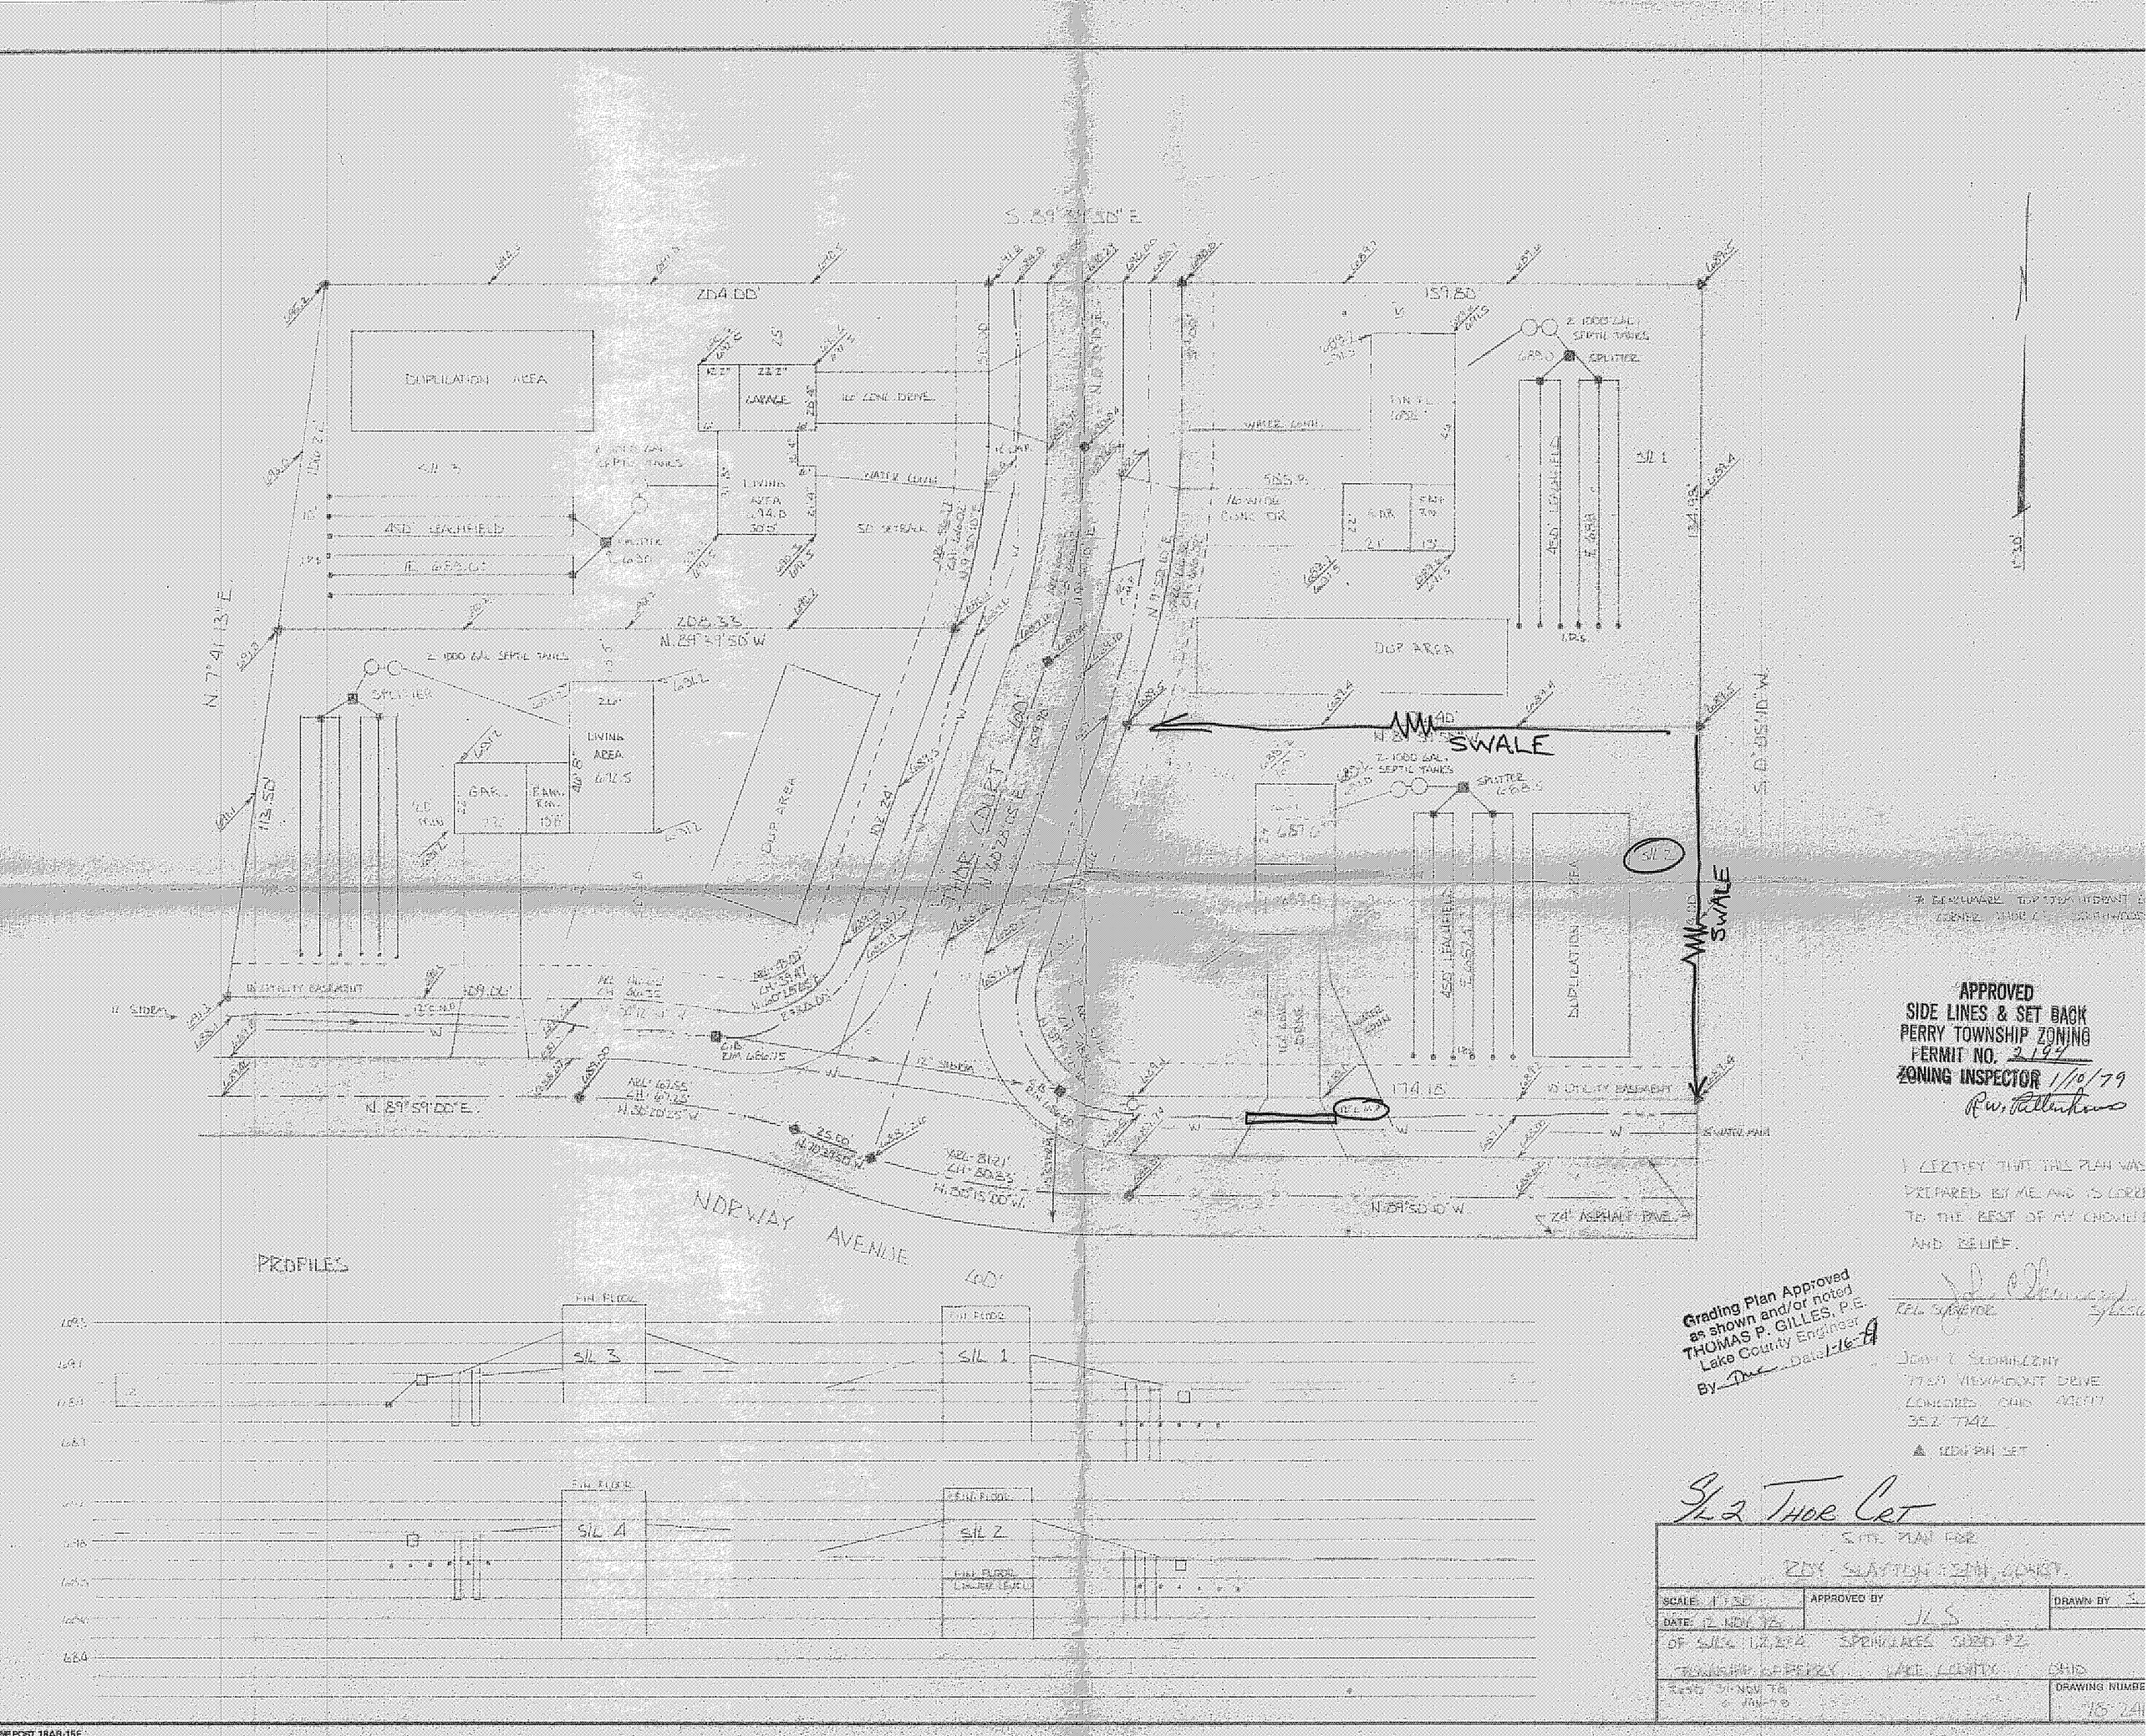

APPROVED
SIDE LINES & SET BACK
PERRY TOWNSHIP ZONING
PERMIT NO. 2194
ZONING INSPECTOR 1/10/79
R.W. Pattenhouse

I CERTIFY THAT THIS PLAN WAS PREPARED BY ME AND IS CORRECT TO THE BEST OF MY KNOWLEDGE AND BELIEF.

REG. SURVEYOR

JOHN T. SCOMBERNY
7750 VIEWMOUNT DRIVE
CONCORD OHIO 44077
352-7742

▲ IRON PIN SET

Grading Plan Approved as shown and/or noted
THOMAS P. GILLES, P.E.
Lake County Engineer
By [signature] Date 1-16-79

S/L 2 THOR CRT

SITE PLAN FOR
ROY SLAYTON & SON CONST.

SCALE: 1:30	APPROVED BY	DRAWN BY
DATE: 12 NOV 78	J.L.S.	

OF SUBS. 1, 2, 3 & 4 SPRINGLAKES SUBD #2
TOWNSHIP OF PERRY LAKE COUNTY OHIO

REVD 31 NOV 78
6 JAN 79

DRAWING NUMBER
78-24

NEPOST 18AB-15E