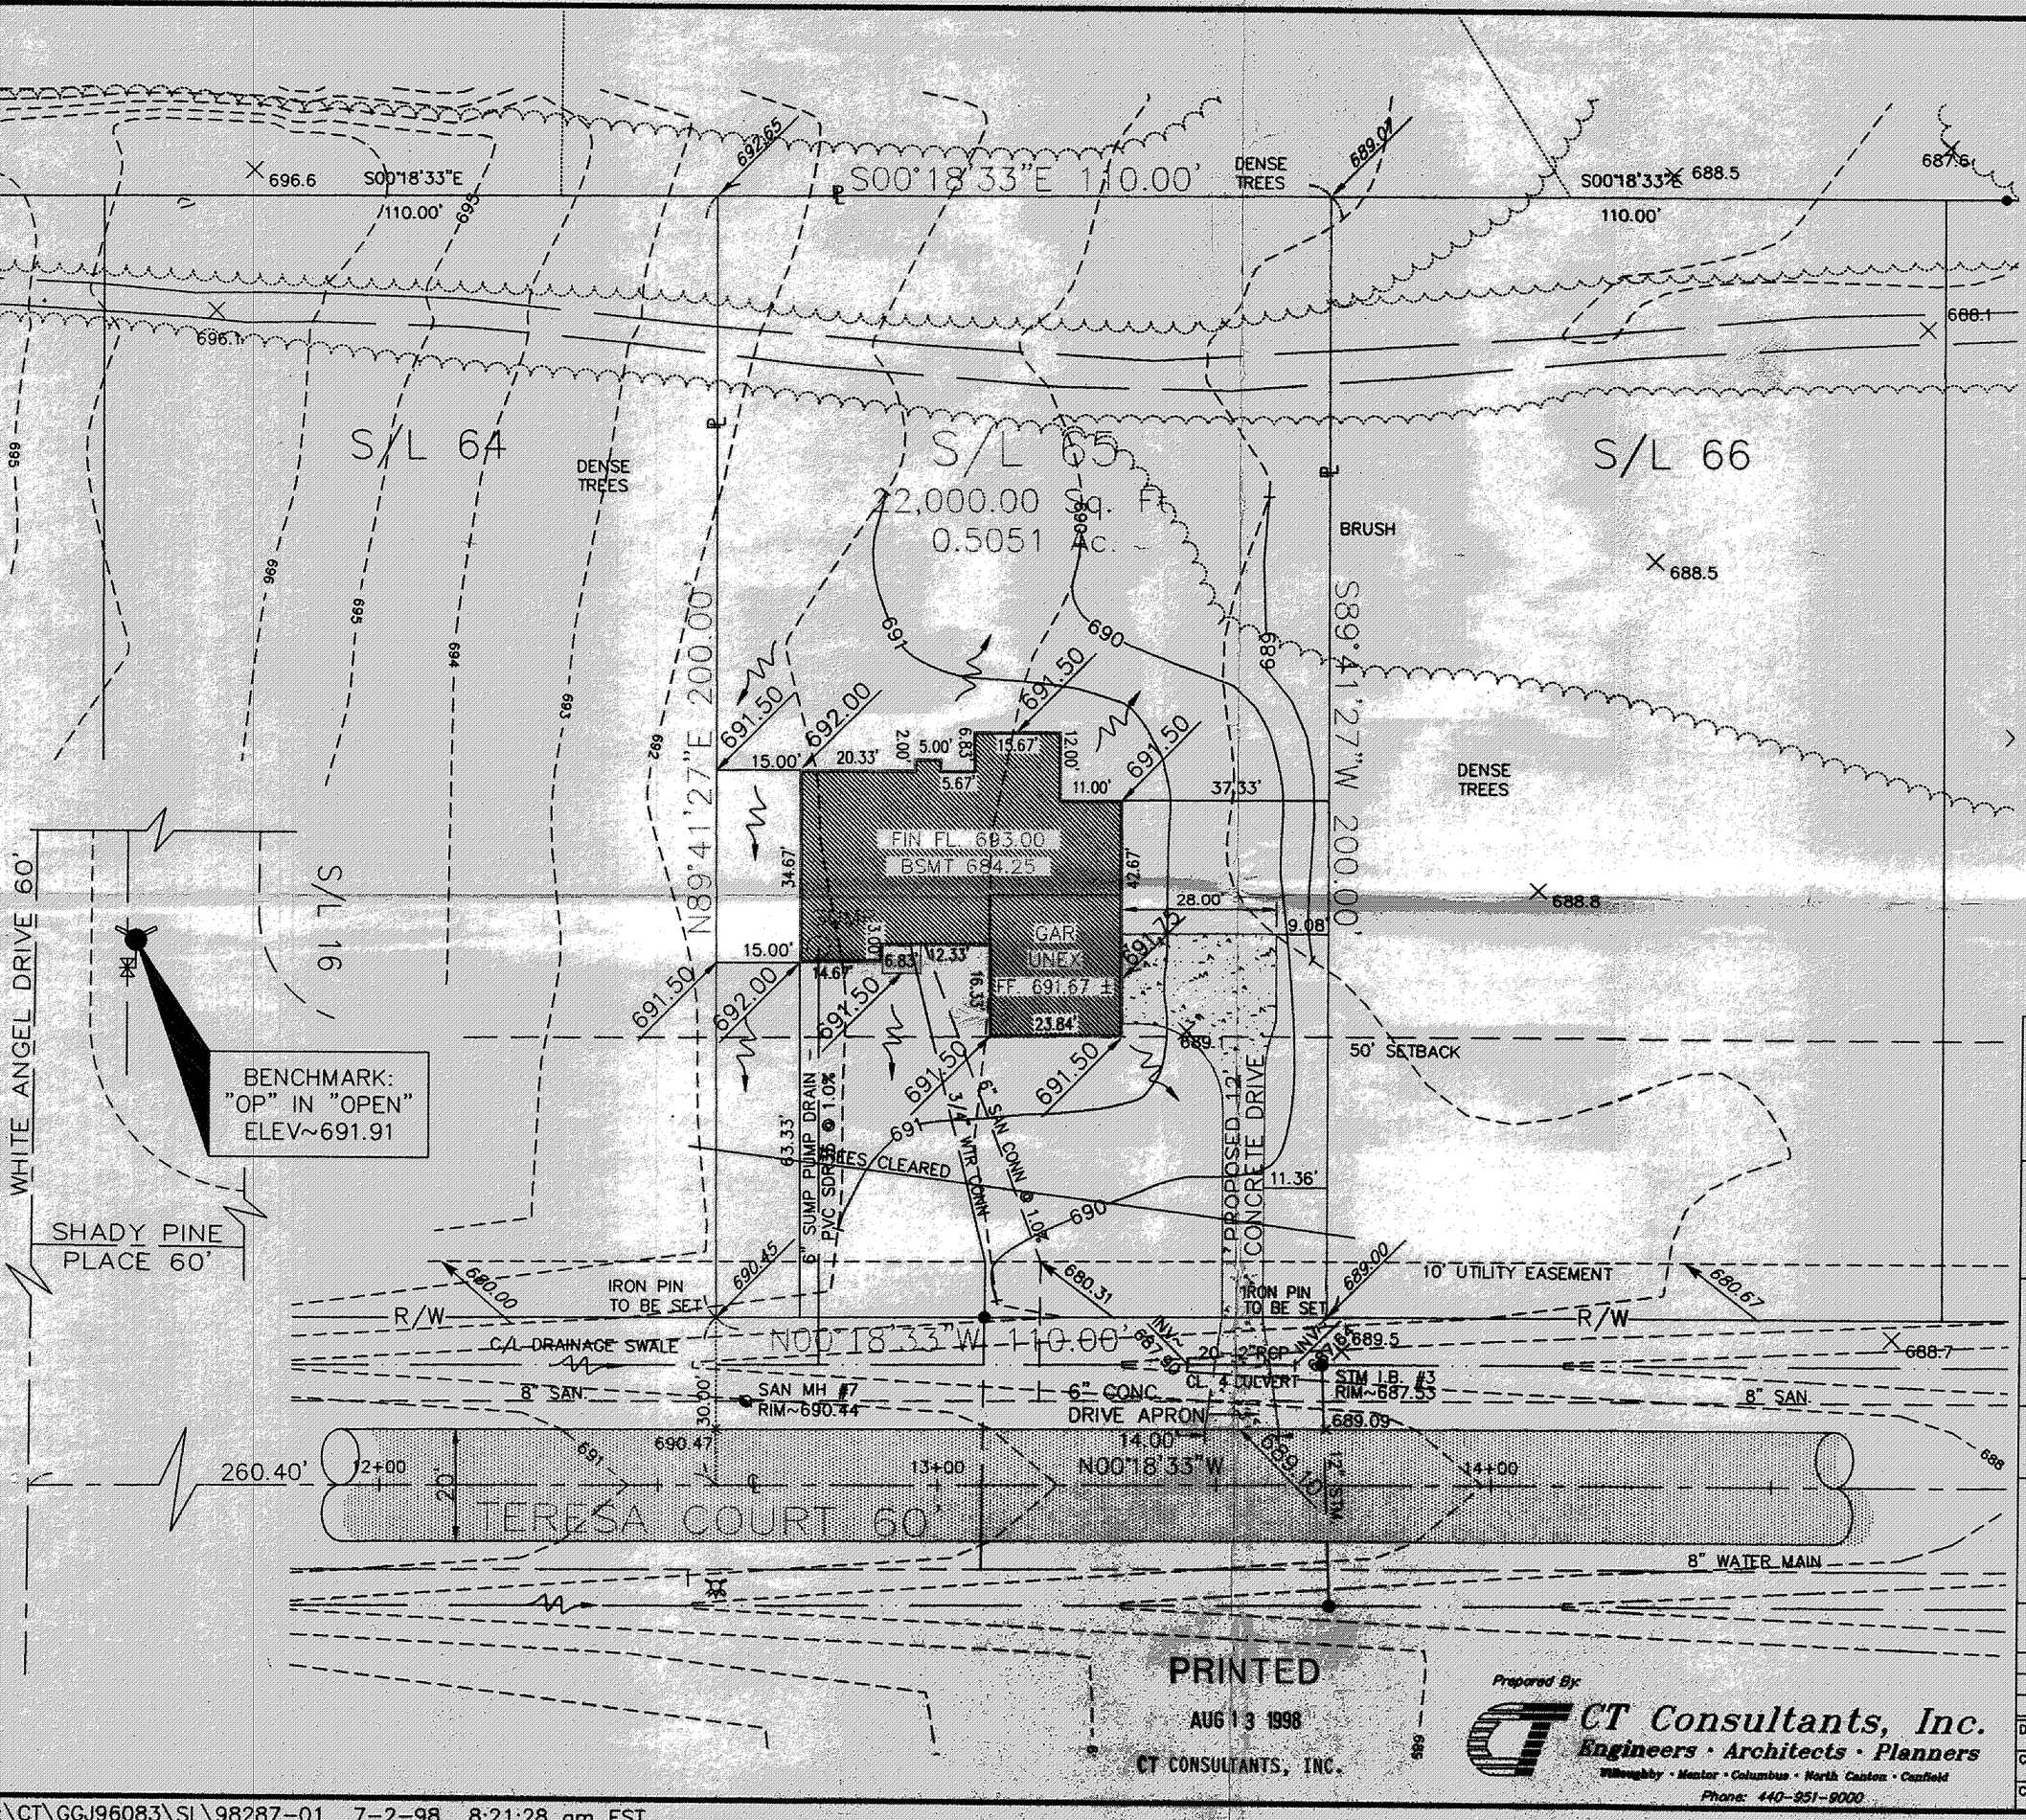

APPROVED
SIDE LINES & SET BACK
PERRY TOWNSHIP ZONING
PERMIT NO. 6694
ZONING INSPECTOR

NORTH

Grading Plan Approved as shown and/or noted
THOMAS P. GILLES, P.E.
Lake County Engineer
By GJH Date 9.1.98

NOTES:
1.) ALL DOWNSPOUTS TO OUTLET ON SPLASH BLOCKS.
2.) THE TWO FRONT IRON PINS BE SET AFTER FINAL GRADI

STATE OF OHIO
J. WESLEY HALL
E-58381
REGISTERED
PROFESSIONAL ENGINEER

Benchmark:
HYDRANT AT THE INTERSECTION OF ANGLE DRIVE AND SHADY PINE PL
"OP" IN "OPEN" ELEV~691.9

SITE PLAN

Lake COUNTY, OHIO

for: Loreto Construction Co. (client / owner)

38650 Willoughby Hills, Ohio 44094 (address / street / city / zip)

Red Mill Run Subd No. 2-Phase 1 (subdivision name) lot tract

volume and page volume page

65 Teresa Court (sublot no. / street) pp no. street

LEGEND

SANITARY MANHOLE
STORM MANHOLE
INLET OR CATCH BASIN
HYDRANT
EXISTING CONTOURS
PROPOSED CONTOURS
EXIST. ELEVATIONS
PROP. ELEVATIONS
INDICATES DIRECTION OF SURFACE DRAINAGE

REMARKS

ALL BOUNDARY DATA SHOWN WAS OBTAINED FROM DEEDS, RECORDED SUBDIVISON PLATS OR OTHER PUBLIC RECORDS.

DESIGN CERTIFICATION

THIS PLAN WAS PREPARED BY ME, AND IS CORRECT TO THE BEST OF MY KNOWLEDGE.

J. Wesley Hall
J. WESLEY HALL REG. ENGINEER No# 58381

REVISION

NO.	DESCRIPTION	DATE
1	15' SIDE YARD SETBACK	8/12/9

DRAWN BY Lombard	SCALE 1"=20'	PHONE NO. 440-95
CHECKED BY Hall	DATE July 1998	CONTACT
CREW CHIEF	APPROVED JWH	DRAWING NO. 96083/SL/98

PRINTED
AUG 13 1998
CT CONSULTANTS, INC.

Prepared By:
CT Consultants, Inc.
Engineers · Architects · Planners
Willoughby · Mentor · Columbus · North Canton · Canfield
Phone: 440-951-9000

\CT\GGJ96083\SL\98287-01 7-2-98 8:21:28 am EST

9