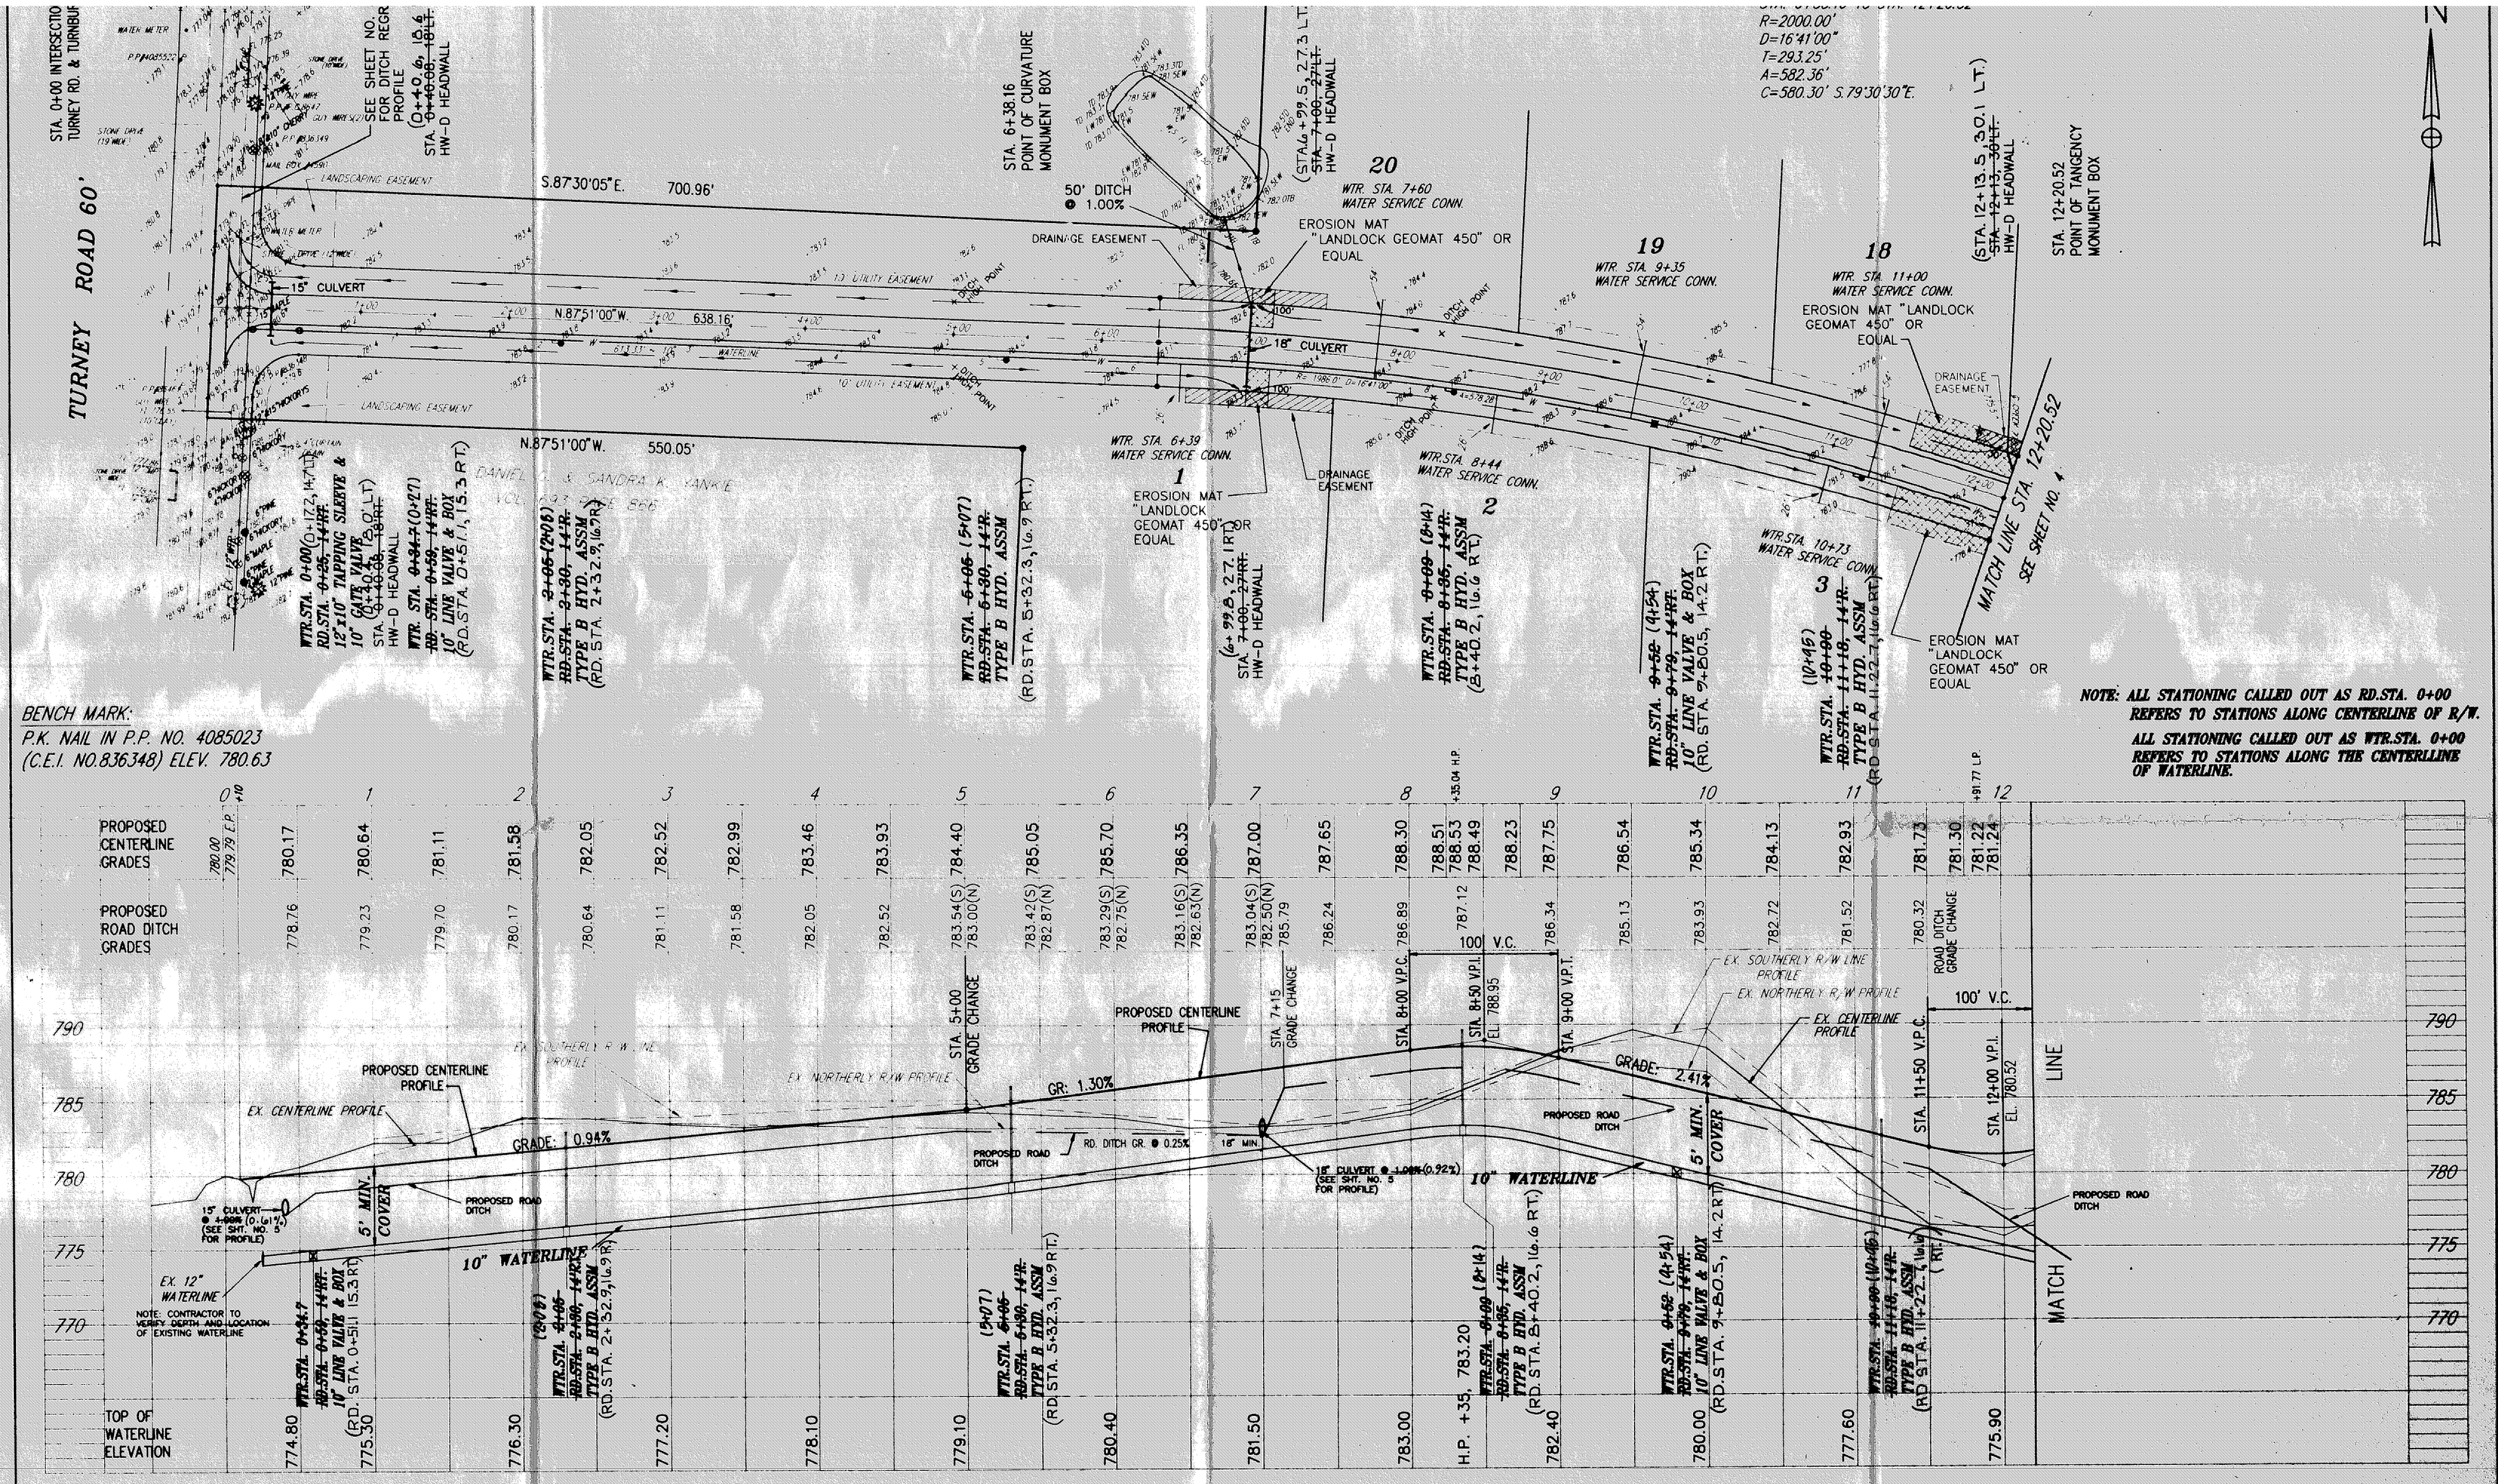

NOTE: ALL STATIONING CALLED OUT AS RD.STA. 0+00 REFERS TO STATIONS ALONG CENTERLINE OF R/W.

ALL STATIONING CALLED OUT AS WTR.STA. 0+00 REFERS TO STATIONS ALONG THE CENTERLINE OF WATERLINE.

CT Consultants, Inc.
Engineers • Architects • Planners
Willoughby • Mentor • Columbus • Lorain • North Canton • Youngstown

REV. NO.	DESCRIPTION	DATE	BY	CH'K'D.
1	AS-BUILT INFORMATION ADDED ( ) FB.1026 Pg. 11-15	11-28-94	R.T.	C.B.

TURNBURY SUBDIVISION
TOWNSHIP OF PERRY
COUNTY OF LAKE, STATE OF OHIO

DATE: SEPT. 1993
DRAWN BY: C.D.B.
CHECKED BY: --
APPROVED BY: --

IMPROVEMENT PLANS
TURNBURY DRIVE 60'
STA. 0+00 TO STA. 12+20.52
PLAN & PROFILE

93120401.DWG
SCALES: HOR. 1" = 50' VERT. 1" = 5'
CONTRACT No. 93120
SHEET NO. 7 OF 44