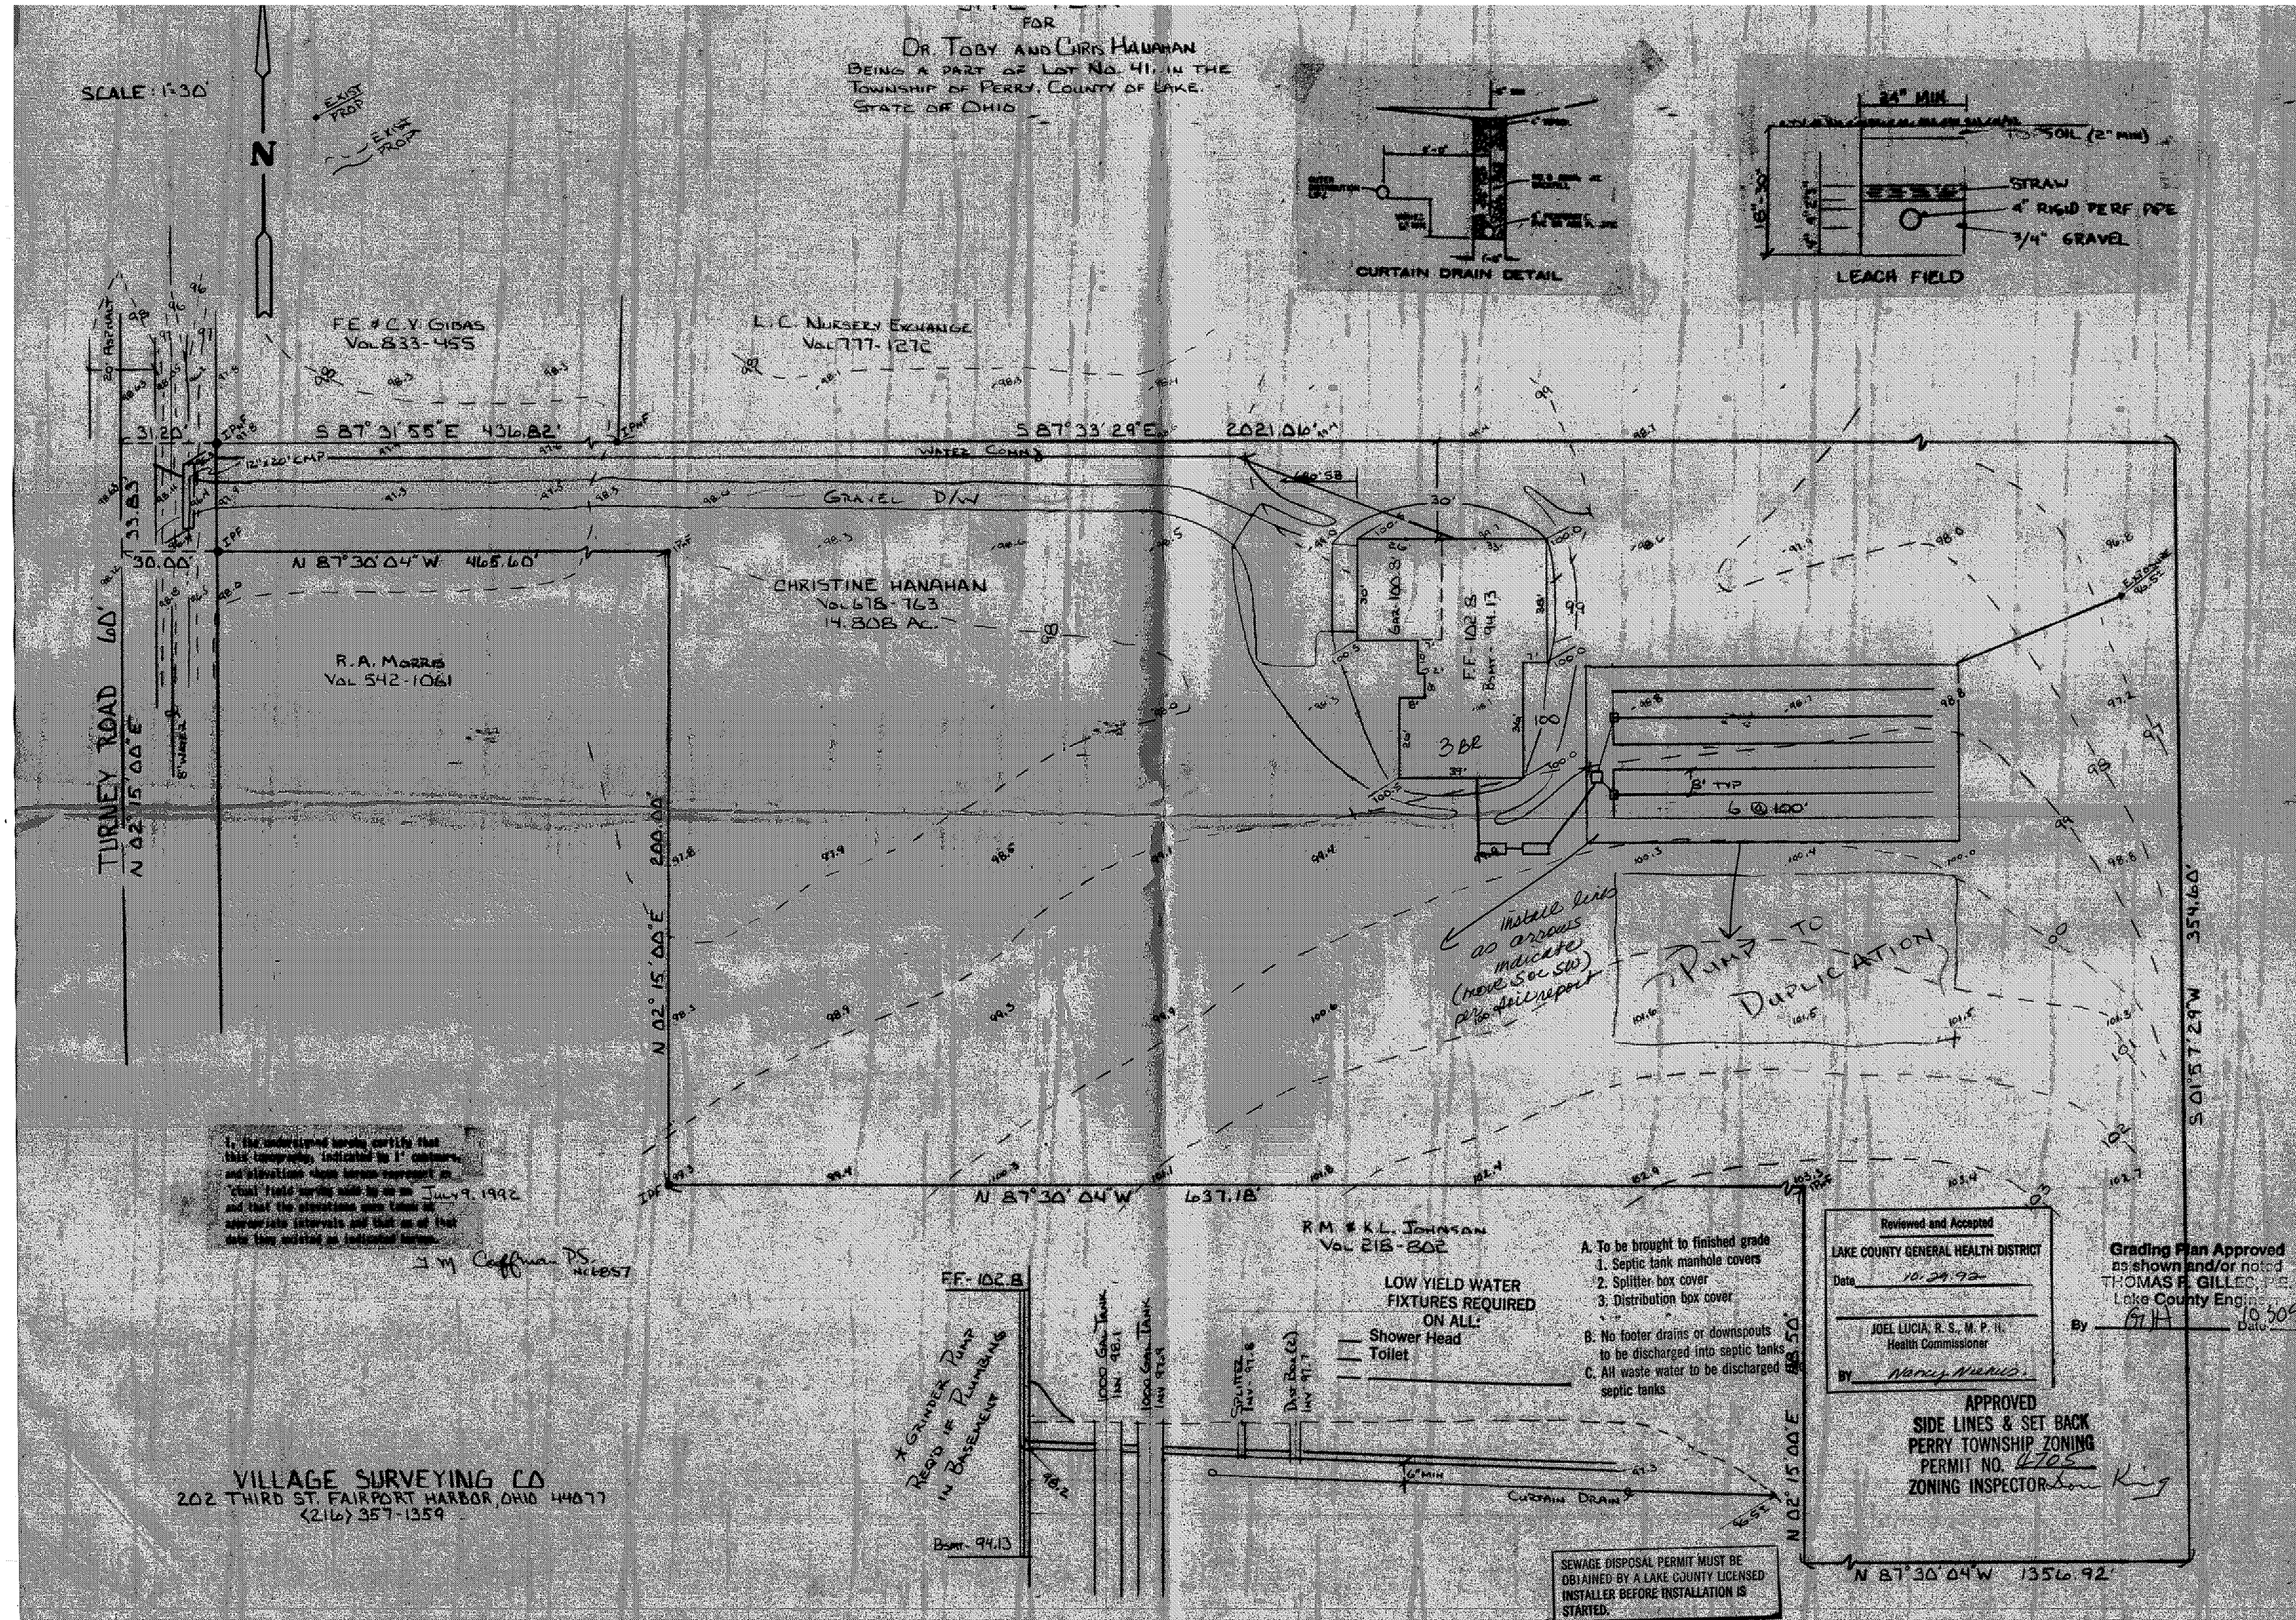

FOR
DR. TOBY AND CHRIS HANAHAN
BEING A PART OF LOT NO. 41, IN THE TOWNSHIP OF PERRY, COUNTY OF LAKE, STATE OF OHIO
SCALE: 1"=30'
N
EXIST PROP
CURTAIN DRAIN DETAIL
24" MIN
SOIL (2" MIN)
STRAW
4" RIGID PERF PIPE
3/4" GRAVEL
LEACH FIELD
F.E. & C.V. GIBAS
VOL 833-455
L.C. NURSERY EXCHANGE
VOL 777-1272
S 87°31'55"E 436.82'
S 87°33'29"E 2021.06'
WATER CONN
GRAVEL D/W
N 87°30'04"W 465.60'
CHRISTINE HANAHAN
VOL 678-763
14.808 AC.
R.A. MORRIS
VOL 542-1061
TURNEY ROAD 60'
N 02°15'00"E
N 02°15'00"E 200.00'
S 01°57'29"W 354.60'
N 87°30'04"W 637.18'
N 87°30'04"W 1356.92'
N 02°15'00"E 88.50'
3 BR
6 @ 100'
PUMP TO DUPLICATION
install lines as arrows indicate (move 50' SW) per soil report
R.M. & K.L. JOHNSON
VOL 218-802
FF-102.8
GRINDER PUMP REQ'D IF PLUMBING IN BASEMENT
1000 GAL TANK INV 98.1
1000 GAL TANK INV 97.9
SPLITTER INV 97.8
DIST BOX (2) INV 97.7
CURTAIN DRAIN
6" MIN
BSMT 94.13
LOW YIELD WATER FIXTURES REQUIRED ON ALL:
Shower Head
Toilet
A. To be brought to finished grade
1. Septic tank manhole covers
2. Splitter box cover
3. Distribution box cover
B. No footer drains or downspouts to be discharged into septic tanks
C. All waste water to be discharged septic tanks
Reviewed and Accepted
LAKE COUNTY GENERAL HEALTH DISTRICT
Date 10.29.92
JOEL LUCIA, R.S., M.P.H.
Health Commissioner
BY Nancy Nieves
Grading Plan Approved as shown and/or noted
THOMAS P. GILLES, P.E.
Lake County Engineer
By GH Date 10.30
APPROVED
SIDE LINES & SET BACK
PERRY TOWNSHIP ZONING
PERMIT NO. 4705
ZONING INSPECTOR Don King
SEWAGE DISPOSAL PERMIT MUST BE OBTAINED BY A LAKE COUNTY LICENSED INSTALLER BEFORE INSTALLATION IS STARTED.
VILLAGE SURVEYING CO
202 THIRD ST. FAIRPORT HARBOR, OHIO 44077
(216) 357-1359