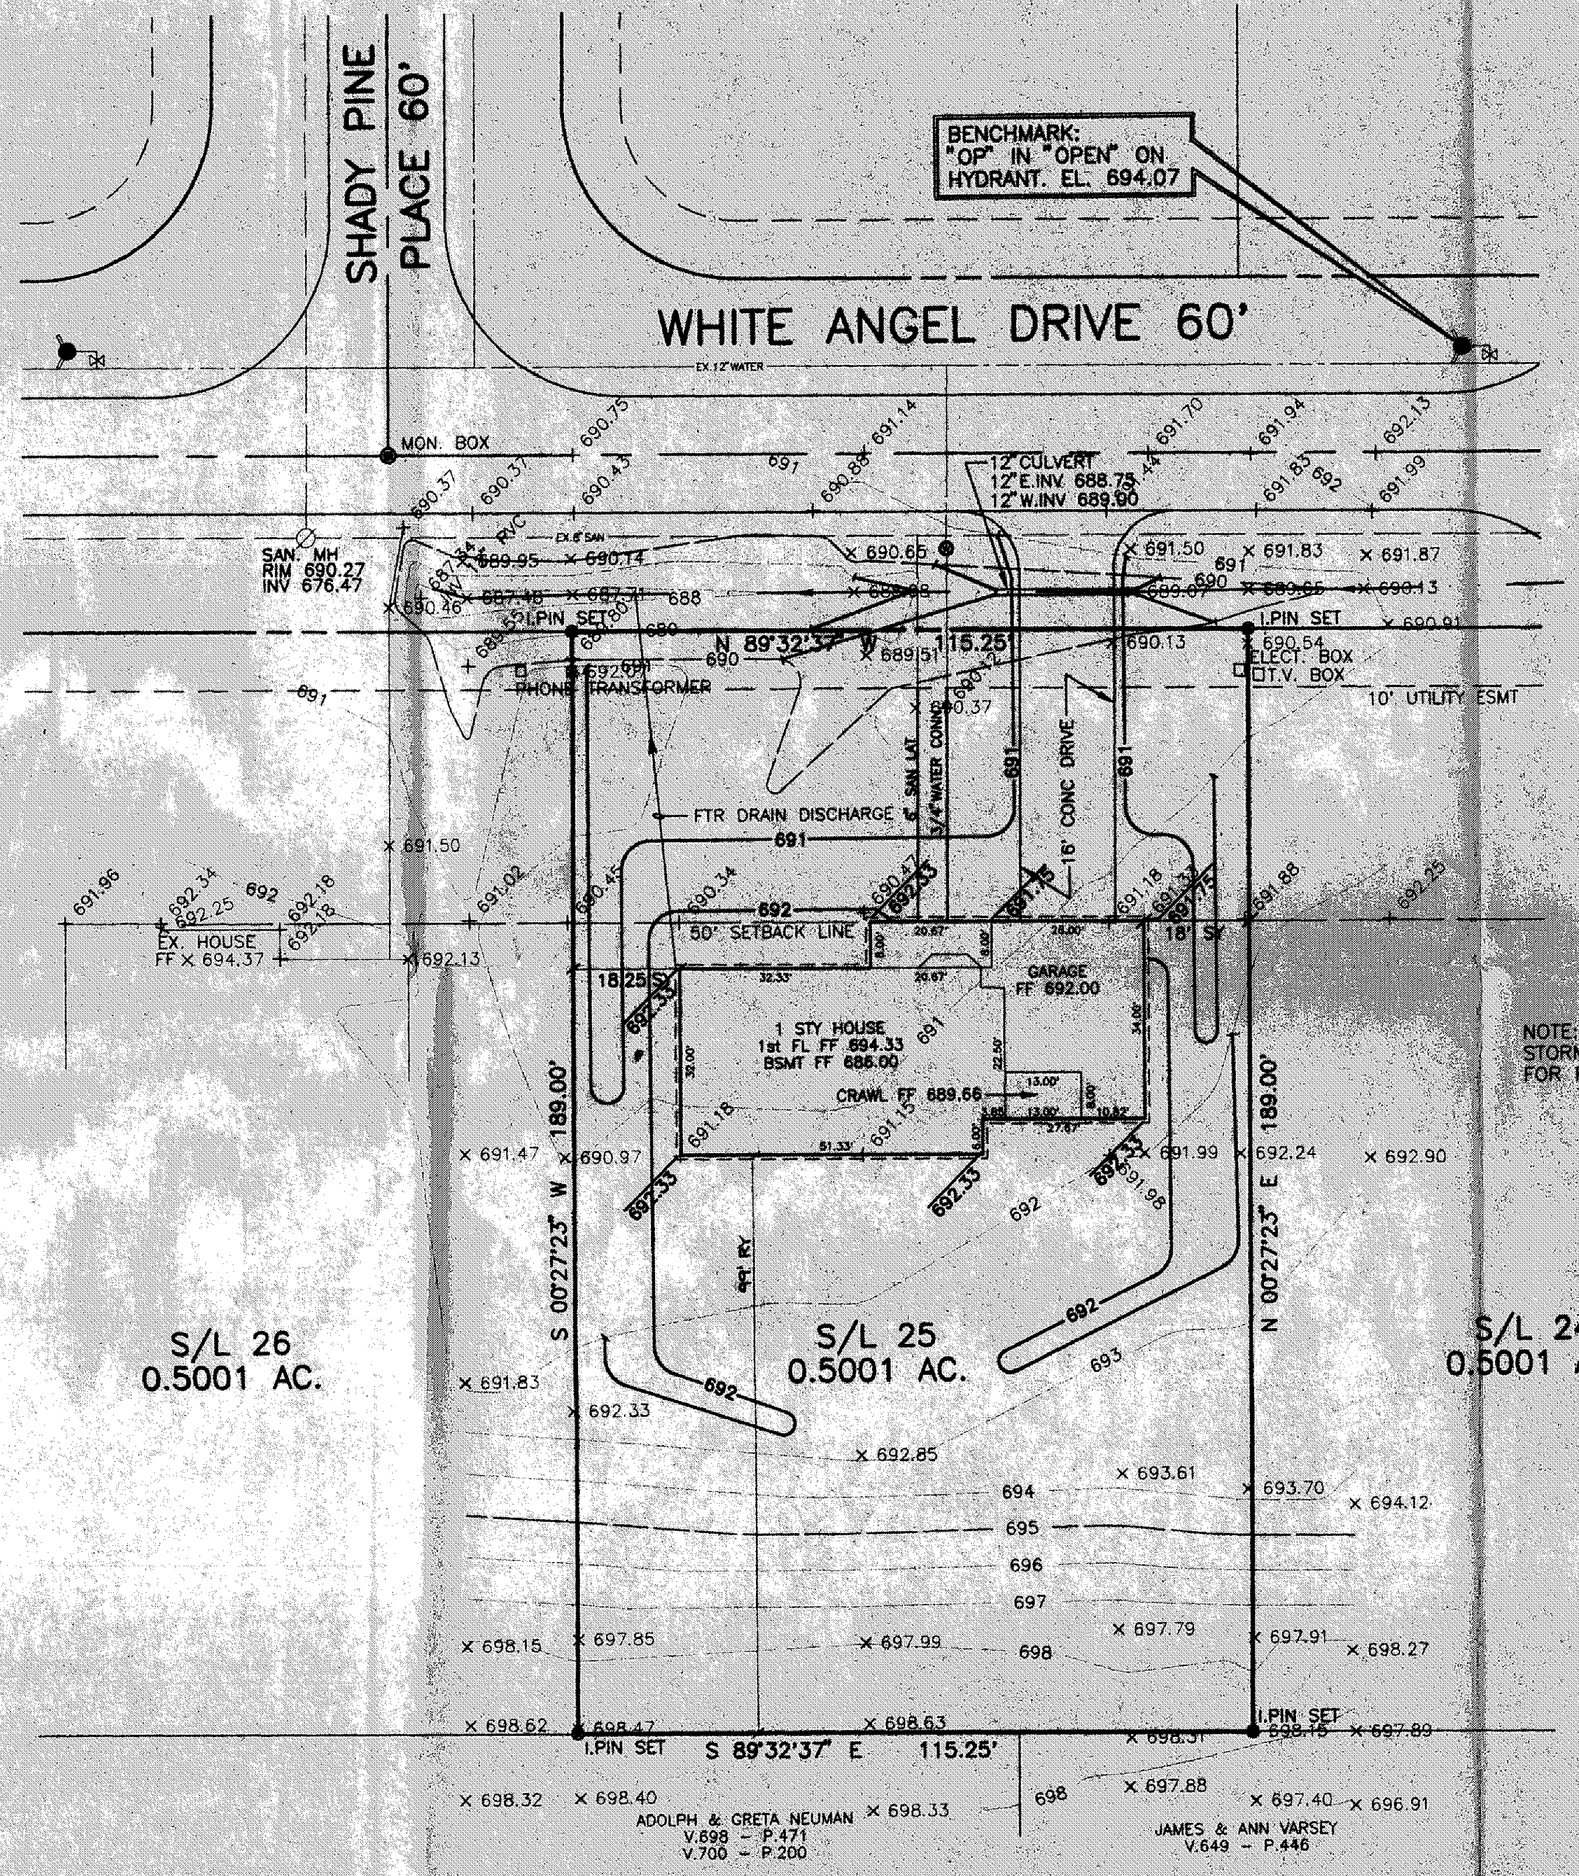

NOTE:
STORM SUMP PUMP REQUIRED
FOR FOOTER DRAIN

APPROVED
SIDE LINES & SET BACK
PERRY TOWNSHIP ZONING
PERMIT NO. _____
ZONING INSPECTOR

APPROVED
SIDE LINES & SET BACK
PERRY TOWNSHIP ZONING
PERMIT NO. 6254
ZONING INSPECTOR

Condition Plan Approved
as shown and/or noted
THOMAS P. GILLES, P.E.
Lake County Engineer
By GHH Date 3/3/95

ROOF DRAINS
SHALL DISCHARGE
TO SPLASH BLOCKS.

SITE PLAN

LAKE COUNTY, OHIO

for: LORETO DEVELOPMENT COMPANY
client owner

38850 FLORENCE DRIVE, WILLOUGHBY HILLS
address street city zip

RED MILL RUN SUBD.	84	
subdivision name	lot	tract
	volume	page
volume and page		
25 WHITE ANGEL DRIVE 60'		
sublot no. street	pp no.	street

LEGEND

- SANITARY MANHOLE
- STORM MANHOLE
- INLET OR CATCH BASIN
- HYDRANT
- EXISTING CONTOURS
- PROPOSED CONTOURS
- EXIST. ELEVATIONS 545.8
- PROP. ELEVATIONS 545.8
- INDICATES DIRECTION OF SURFACE DRAINAGE

REMARKS

ALL BOUNDARY DATA SHOWN WAS OBTAINED FROM DEEDS, RECORDED SUBDIVISON PLATS OR OTHER PUBLIC RECORDS.

DESIGN CERTIFICATION

THIS PLAN WAS PREPARED BY ME, AND IS CORRECT TO THE BEST OF MY KNOWLEDGE.

Stephen L. Guard 7027
SURVEYOR NAME AND REG. NO.

REVISION

NO.	DESCRIPTION	DATE	BY

DRAWN BY TML	SCALE 1"=20'	PHONE NO. PRINTED	
CHECKED BY	DATE 2/95	CONTACT MAR 08 1995	
COPY SENT	APPROVED	DRAWING NO.	

GILLS, GUARD and ASSOCIATES, INC.
CIVIL ENGINEERS & SURVEYORS
7550 CHAGRIN ROAD
CHAGRIN FALLS, OHIO 44023
(216) 247-2800

TOWNSHIP OF PERRY
S/L 25 - RED MILL RUN SUBDIVISION
SITE PLAN

SCALE 1"=20'
CONTRACT NO. 95045
SHEET NO. 1 OF 1

REV. NO.	DESCRIPTION	DATE	BY	CHKD

DATE BY CHKD

DESCRIPTION

DRAWN BY TML
CHECKED BY SLG
APPROVED BY
P.E. No. 9004
REG. SURVEYOR
PLOT DATE 3-10-95

STATE OF OHIO
STEPHEN L. GUARD
7027
REGISTERED
SURVEYOR
PROFESSIONAL

C:\DWG\95045\95045SF.dwg Fri Mar 3 08:03:03 1995