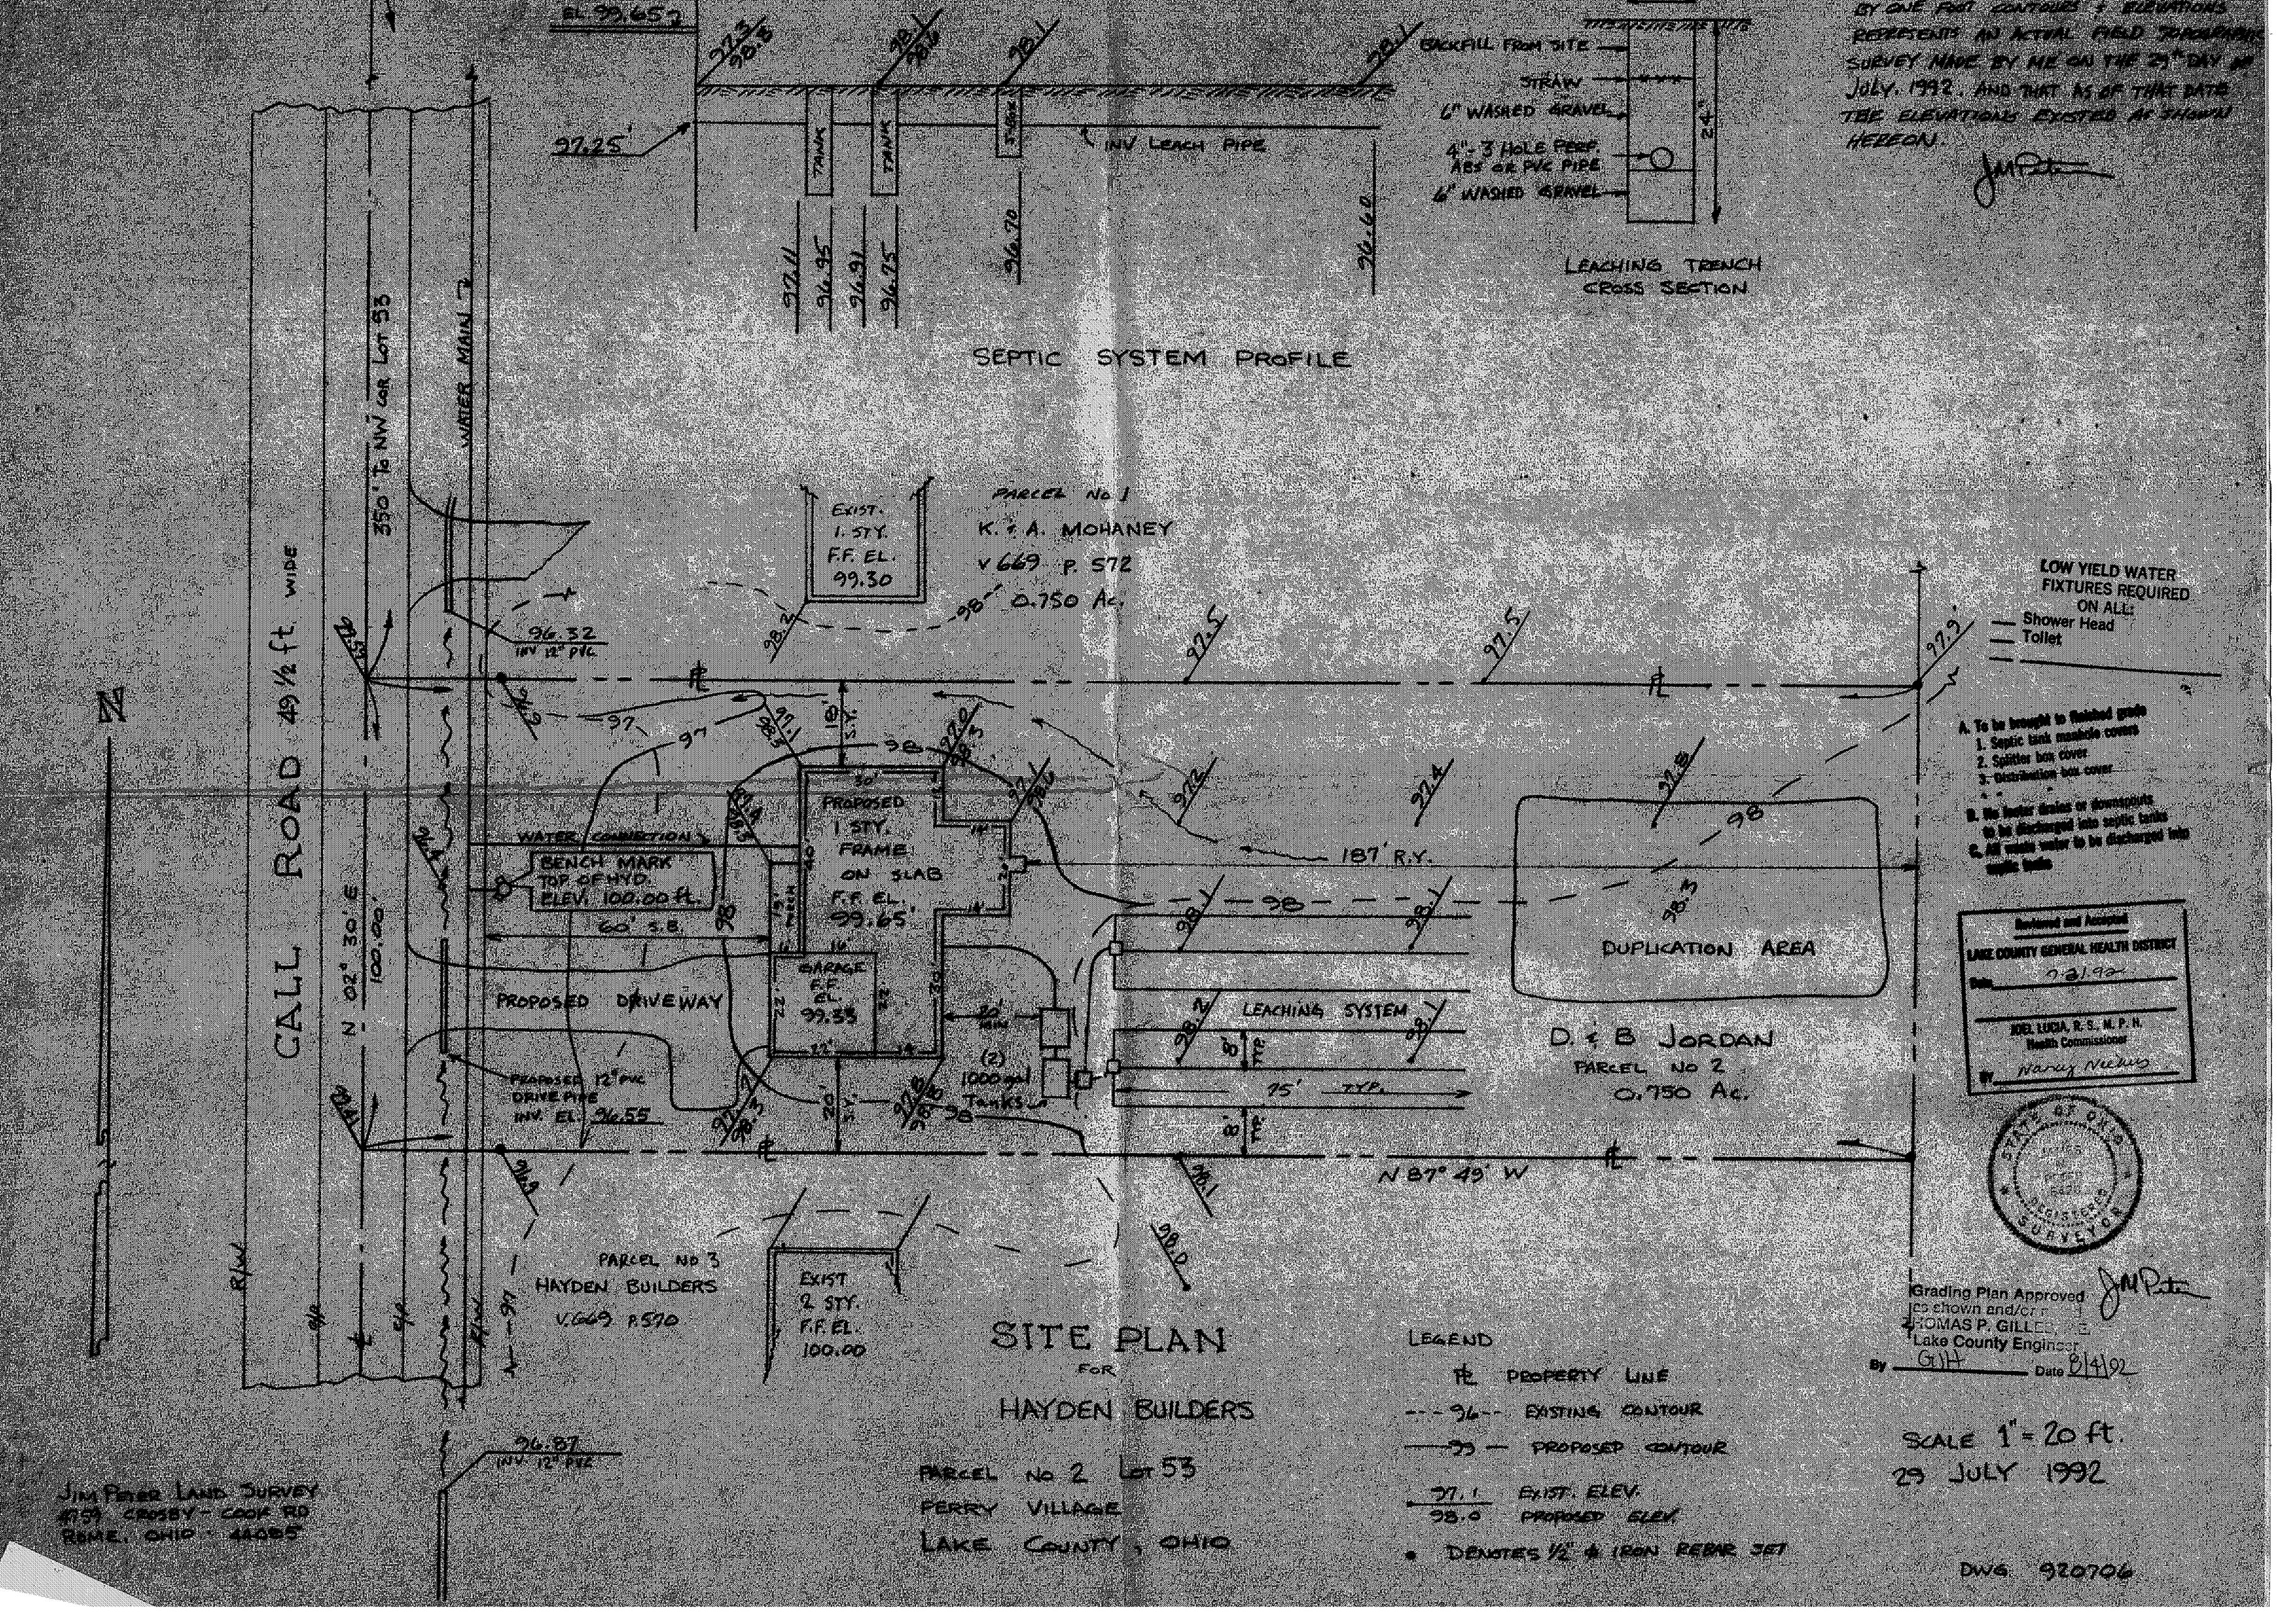BY ONE FOOT CONTOURS & ELEVATIONS REPRESENTS AN ACTUAL FIELD TOPOGRAPHIC SURVEY MADE BY ME ON THE 29th DAY OF JULY, 1992. AND THAT AS OF THAT DATE THE ELEVATIONS EXISTED AS SHOWN HEREON.