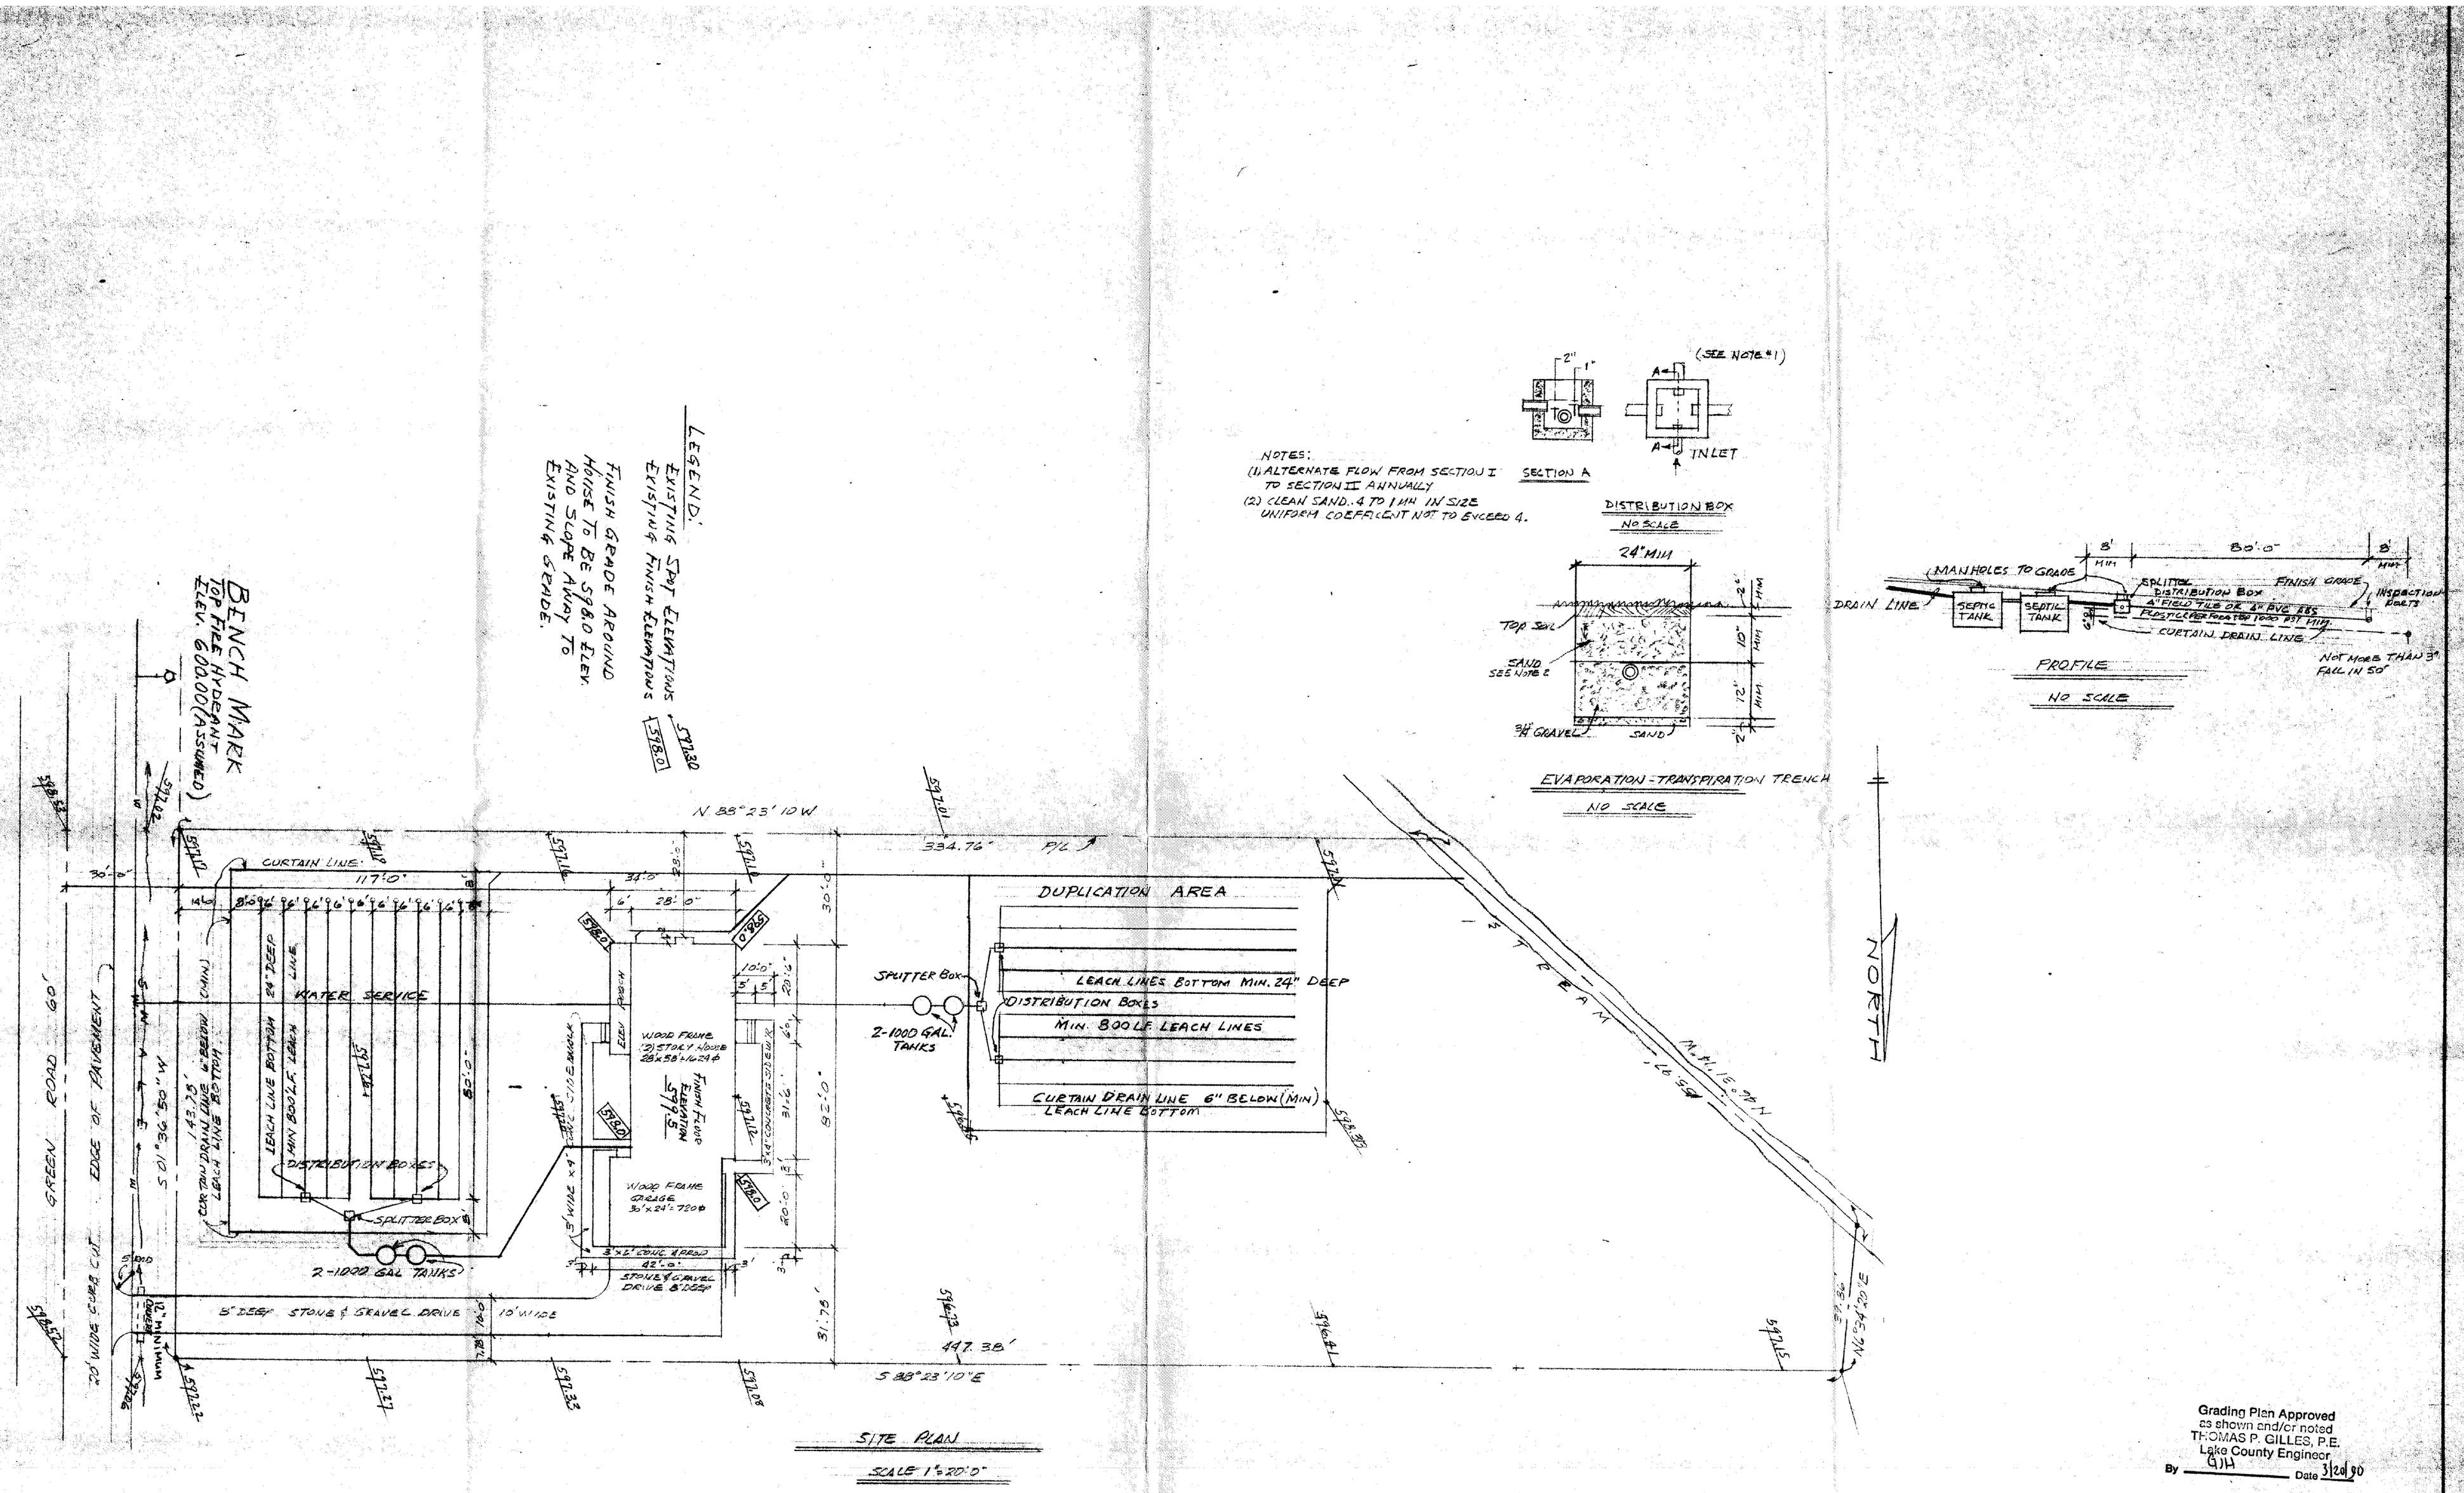

Grading Plan Approved as shown and/or noted
THOMAS P. GILLES, P.E.
Lake County Engineer
By GJH Date 3/20/90

STATE OF OHIO
JAY BALANDO
4804
REGISTERED
SURVEYOR

PLOT PLAN FOR DAVID A. VONLEHMDEN

SCALE: 1"=20'-0	APPROVED BY:	DRAWN BY: E.E.
DATE: 1-7-90		REVISED: 3-10-90

PERM. PARCEL NO. 4A-44D-40 BEING PART OF ORIG. PERRY TOWNSHIP LOT 55, VILLAGE OF PERRY, OHIO