BY ONE FOOT CONTOURS & ELEVATIONS REPRESENTS AN ACTUAL FIELD TOPOGRAPHIC SURVEY MADE BY ME ON THE 30th DAY OF MARCH, 1992 AND THAT THE ELEVATIONS WERE TAKEN AT APPROPRIATE INTERVALS & THAT AS OF THAT DATE THEY EXISTED AS INDICATED HEREON
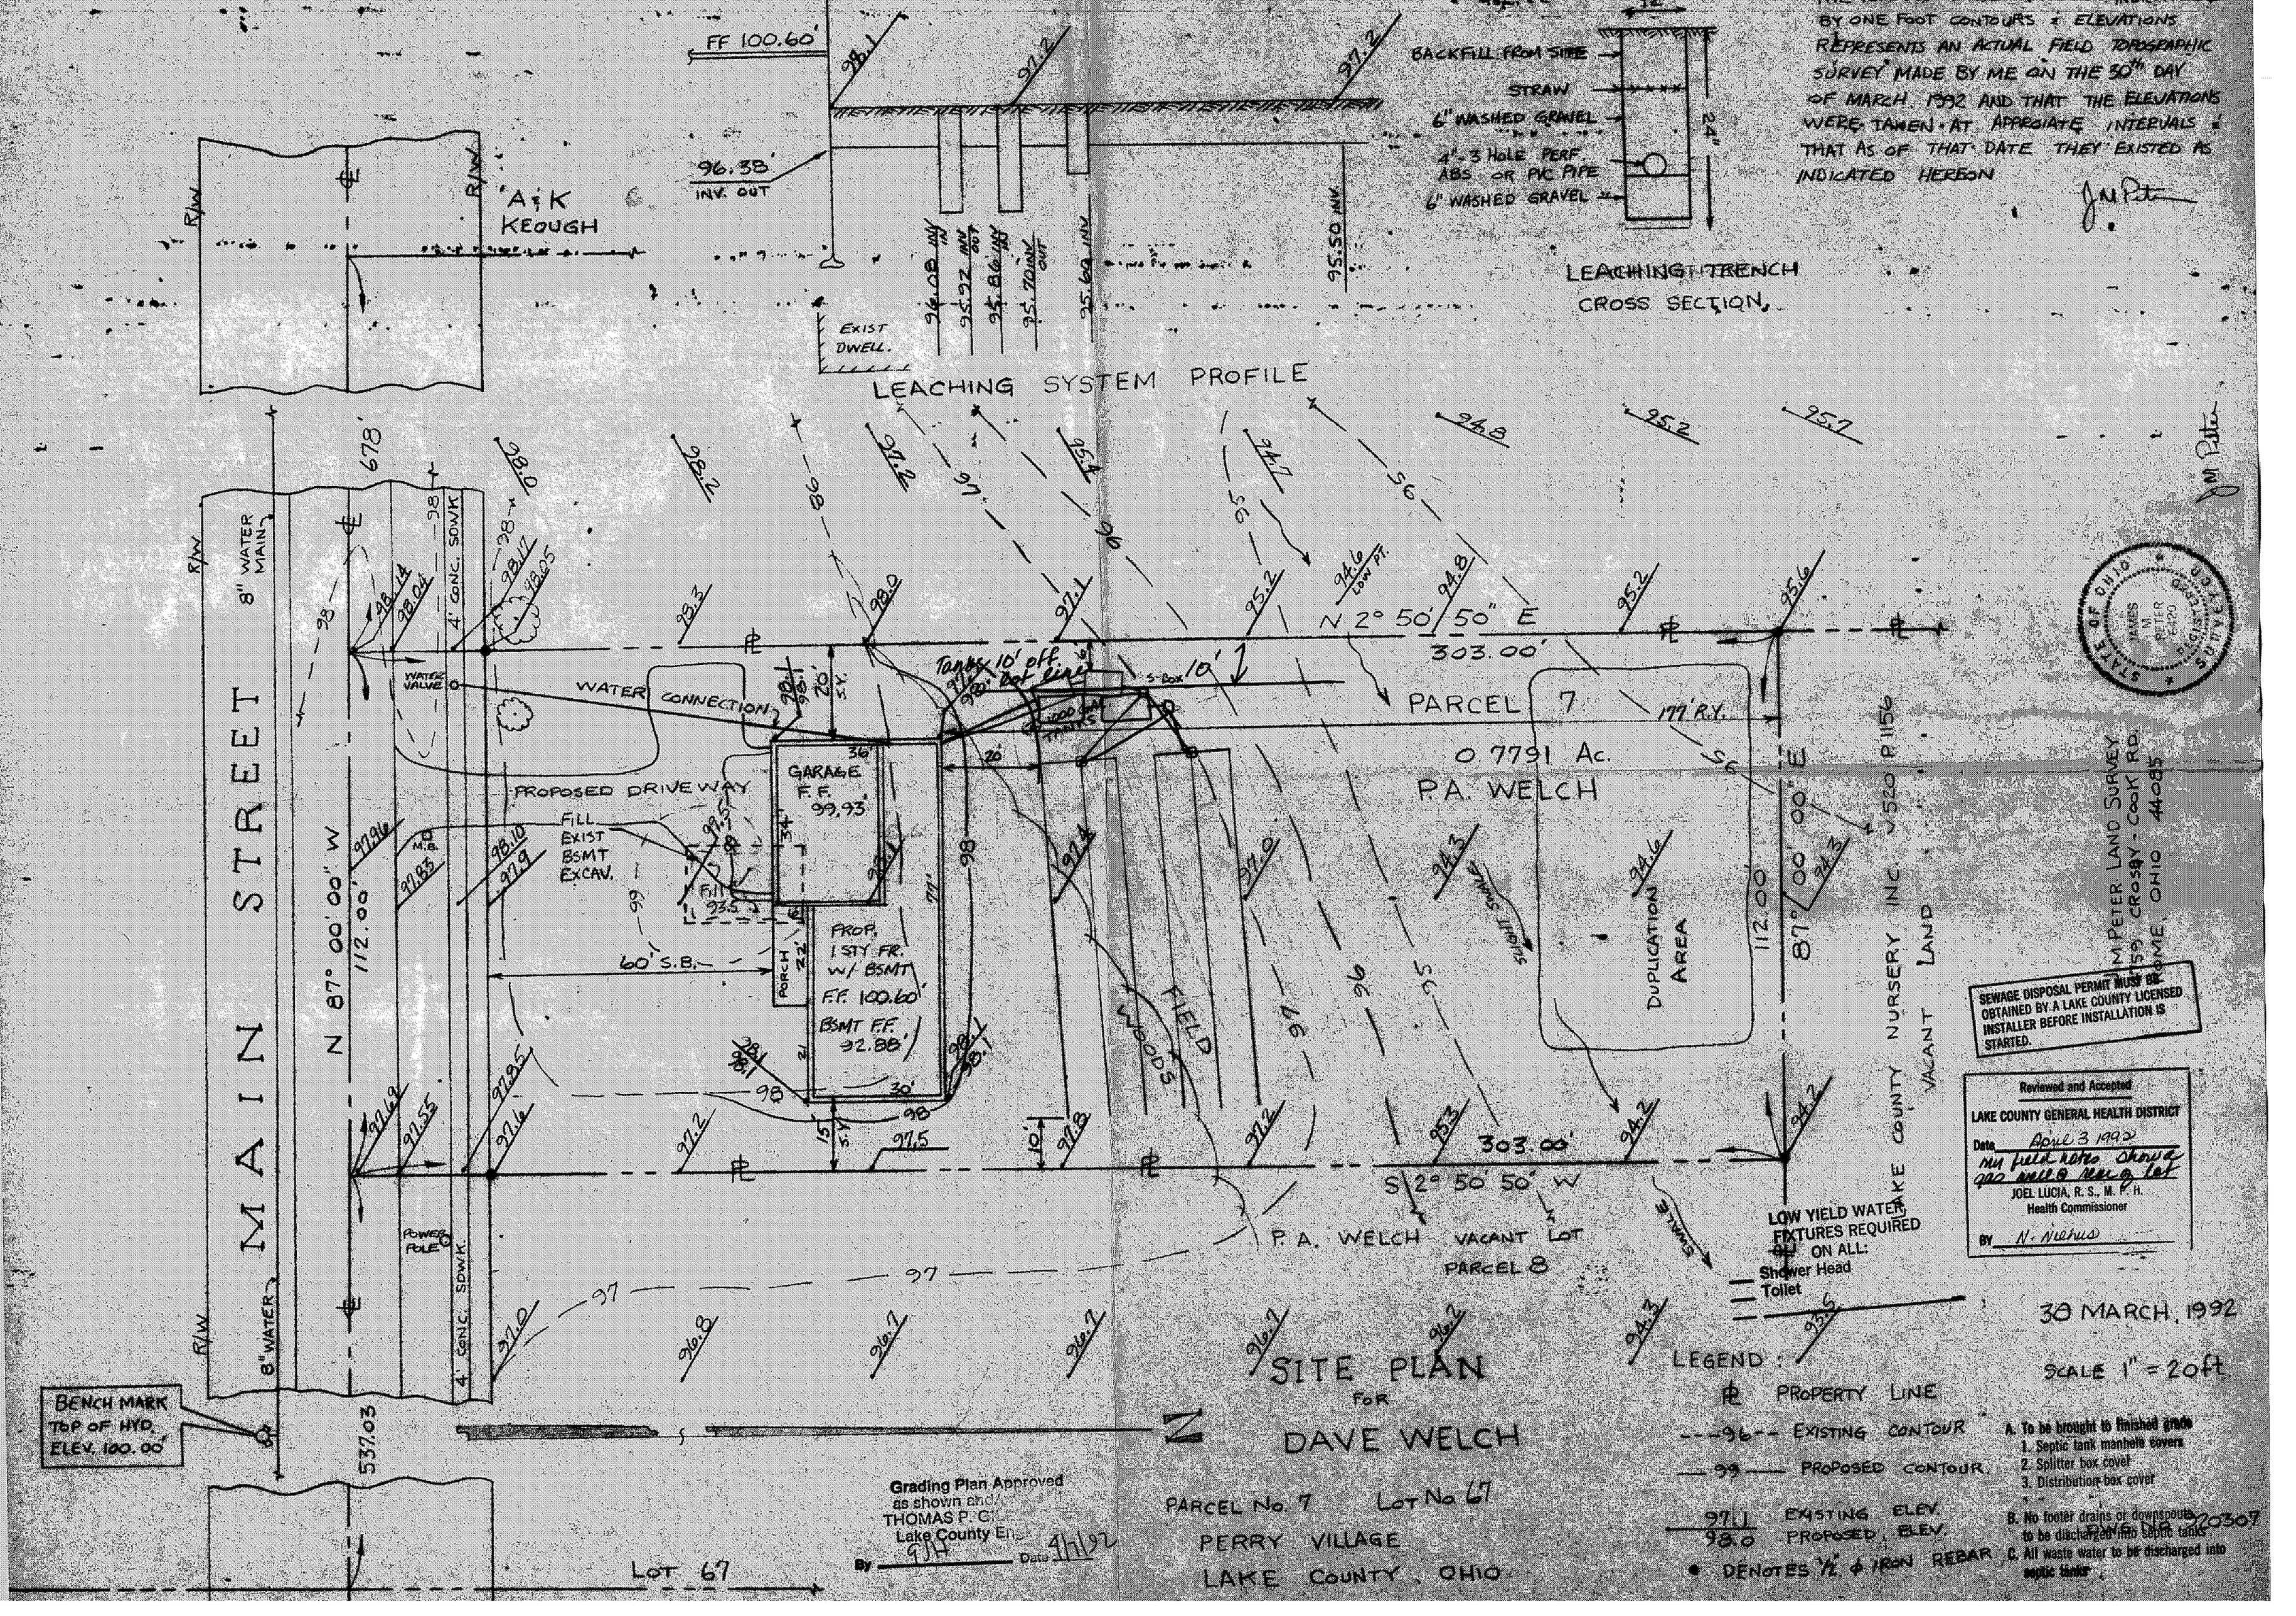
J.M. Peter