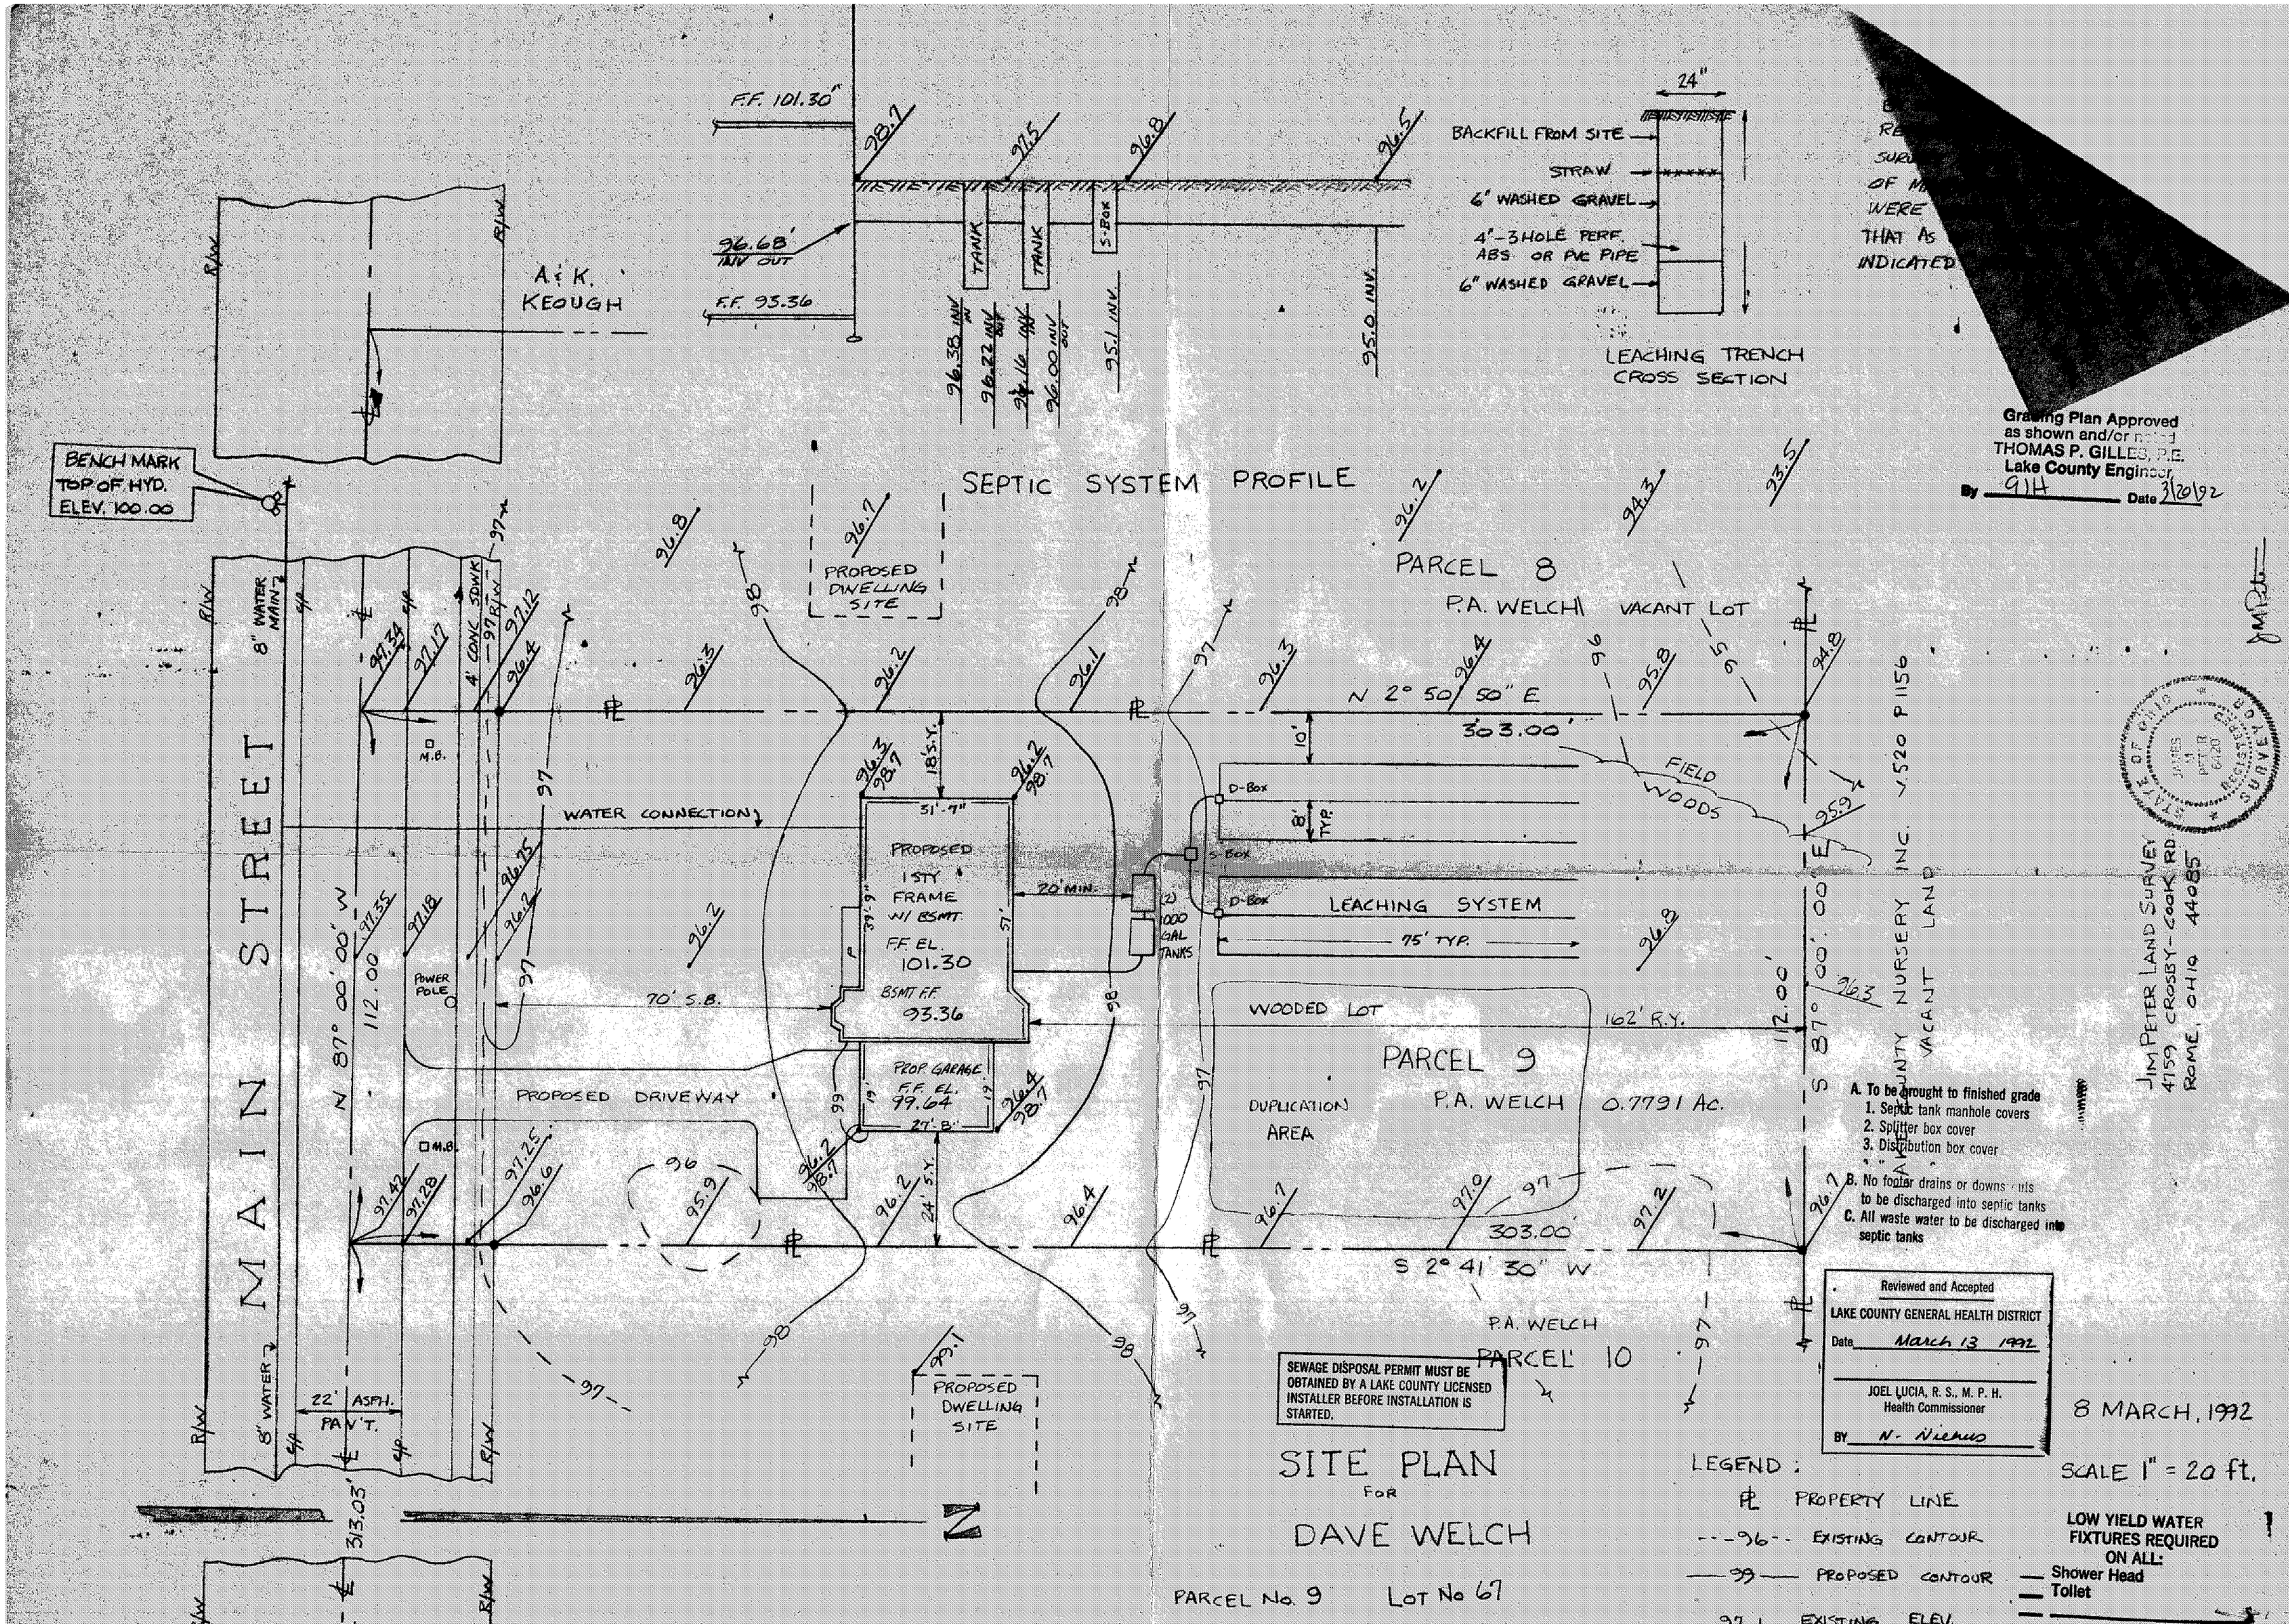

Grading Plan Approved as shown and/or noted
THOMAS P. GILLES, P.E.
Lake County Engineer
By 9H Date 3/20/92

A. To be brought to finished grade
1. Septic tank manhole covers
2. Splitter box cover
3. Distribution box cover

B. No footer drains or downspouts to be discharged into septic tanks

C. All waste water to be discharged into septic tanks

Reviewed and Accepted
LAKE COUNTY GENERAL HEALTH DISTRICT
Date March 13 1992
JOEL LUCIA, R. S., M. P. H.
Health Commissioner
BY N. Nieves

SEWAGE DISPOSAL PERMIT MUST BE OBTAINED BY A LAKE COUNTY LICENSED INSTALLER BEFORE INSTALLATION IS STARTED.

SITE PLAN
FOR
DAVE WELCH

PARCEL No. 9 LOT No 67

8 MARCH, 1992

SCALE 1" = 20 ft.

LEGEND:
℄ PROPERTY LINE
---96-- EXISTING CONTOUR
——99—— PROPOSED CONTOUR
97 EXISTING ELEV.

LOW YIELD WATER FIXTURES REQUIRED ON ALL:
— Shower Head
— Toilet
— ____