REVISIONS
1 MAY 25 97 RELOCATE HOUSE

Grading Plan Approved
as shown and/or noted
THOMAS P. GILLES, P.E.
Lake County Engineer
By 6/14 Date 6-10-97

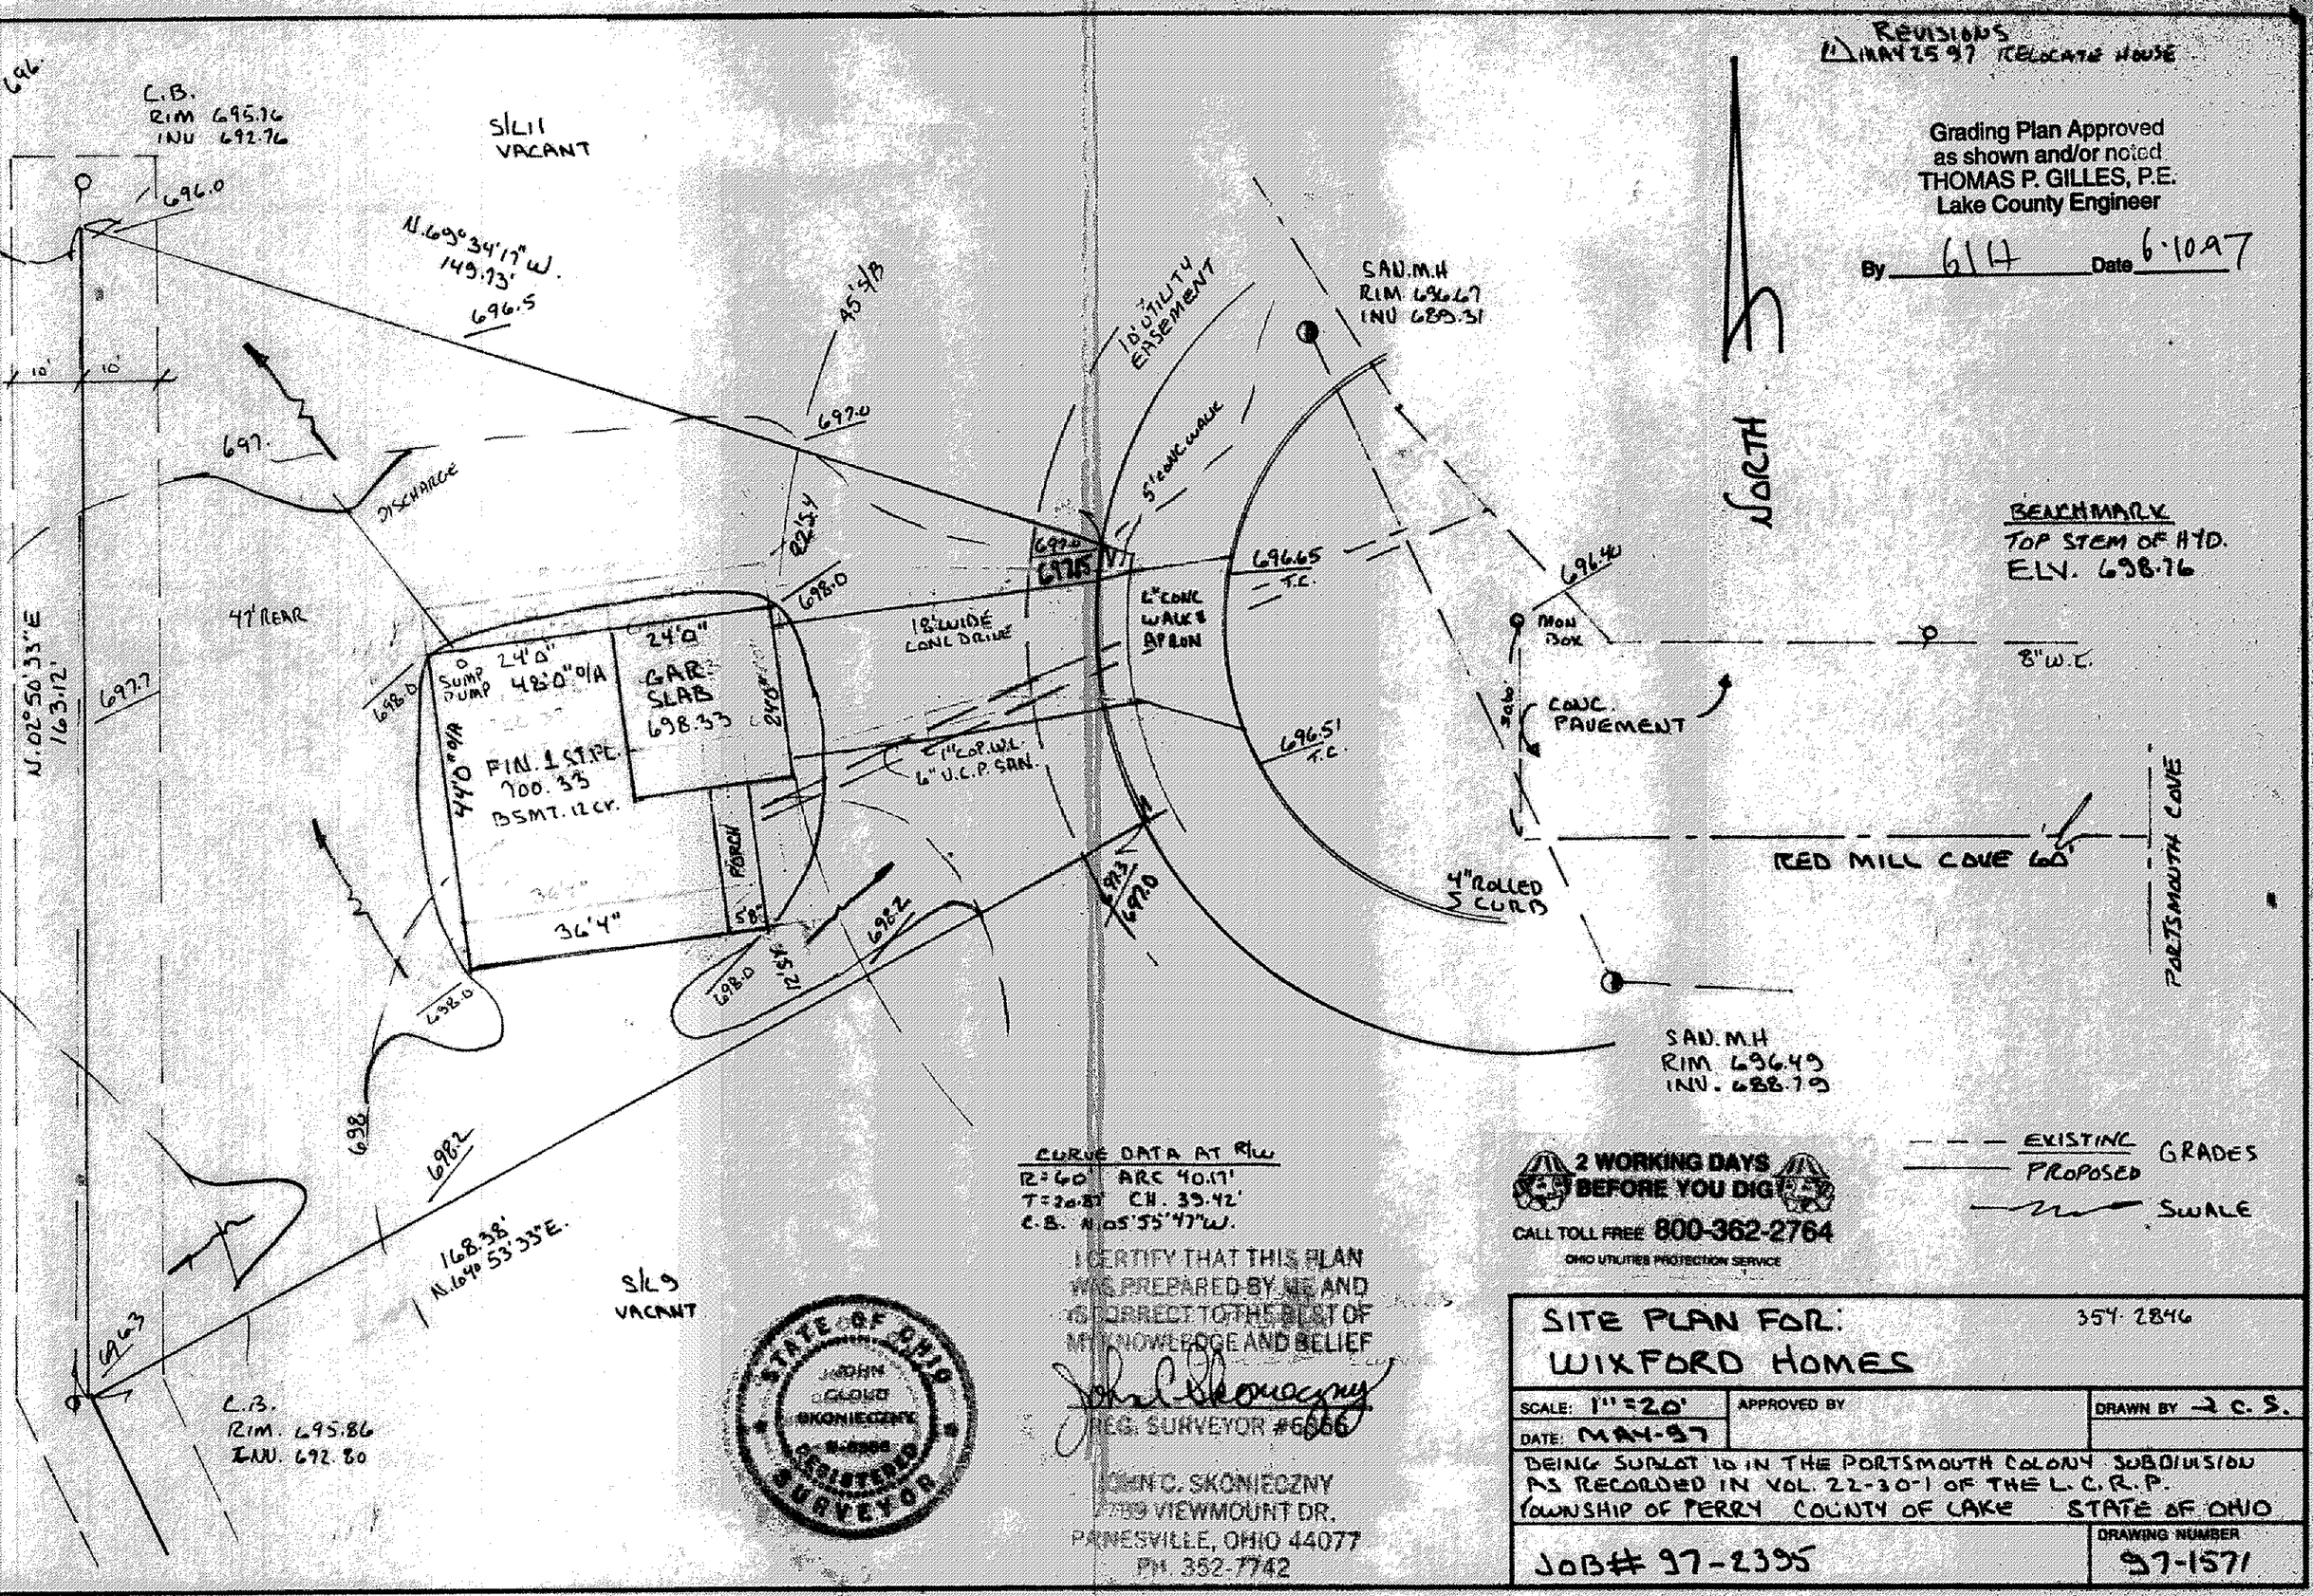

BENCHMARK
TOP STEM OF HYD.
ELV. 698.76

CURVE DATA AT R/W
R=60' ARC 40.17'
T=20.87' CH. 39.42'
C.B. N.05°55'47"W.

2 WORKING DAYS BEFORE YOU DIG!
CALL TOLL FREE 800-362-2764
OHIO UTILITIES PROTECTION SERVICE

— — — EXISTING GRADES
——— PROPOSED
SWALE

I CERTIFY THAT THIS PLAN WAS PREPARED BY ME AND IS CORRECT TO THE BEST OF MY KNOWLEDGE AND BELIEF

John C. Skonieczny
REG. SURVEYOR #6866

STATE OF OHIO
JOHN CLOUD SKONIECZNY
6866
REGISTERED SURVEYOR

JOHN C. SKONIECZNY
7789 VIEWMOUNT DR.
PAINESVILLE, OHIO 44077
PH. 352-7742

SITE PLAN FOR:
WIXFORD HOMES
354-2846

SCALE: 1" = 20'	APPROVED BY	DRAWN BY J. C. S.
DATE: MAY-97		

BEING SUBLOT 10 IN THE PORTSMOUTH COLONY SUBDIVISION AS RECORDED IN VOL. 22-30-1 OF THE L.C.R.P.
TOWNSHIP OF PERRY COUNTY OF LAKE STATE OF OHIO

JOB# 97-2395

DRAWING NUMBER
97-1571