SITE PLAN

Village of Perry LAKE COUNTY, OHIO

for: G.S.M.
CLIENT OWNER

ADDRESS STREET CITY ZIP

Rustic Village #2 SUBDIVISION NAME		LOT	TRACT
	VOL. – PG.	VOLUME	PAGE
30 Whistlewood SUBLOT NO. STREET		PERM. PARCEL NO.	STREET

LEGEND

SANITARY MANHOLE		WATER VALVE (GAS)	
STORM MANHOLE		WATER METER (GAS)	
INLET OR CATCH BASIN		AS BUILT ELEVATION	100.0
HYDRANT		INDICATES DIRECTION OF SURFACE DRAINAGE	
EXISTING CONTOURS			
PROPOSED CONTOURS			
EXIST. ELEV. 100.0	PROP. ELEV. 100.0		

REMARKS

ALL BOUNDARY DATA SHOWN WAS OBTAINED FROM (DEEDS, RECORDED SUBDIVISION PLAT OR OTHER PUBLIC RECORDS)

LOCATIONS AS SHOWN OF ADJACENT WELLS AND SEPTIC TANKS OBTAINED FROM LAKE COUNTY HEALTH DEPARTMENT

DESIGN CERTIFICATION

THIS PLAT WAS PREPARED BY ME, AND IS CORRECT TO THE BEST OF MY KNOWLEDGE AND BELIEF.

Roger L. Blum 5310
NAME/ SURVEYOR REGISTRATION NO.

CHECK LIST

NO. OF BEDROOMS
DIMENSIONS
BEARINGS
TIE TO NEAREST STREET
SUBLOT NO. PARCEL NO.
SURROUNDING OWNERS
BLDG. DIMENSIONS FIN. GR.
BLDG. TIES FL'R. GRADES
APRON TYPE WIDTH THICKNESS
SIDEWALK TYPE WIDTH THICKNESS
CULVERT TYPE DIA., LENGTH
ROCK OUTCROPPINGS

WATER MAIN SIZE, LOCATION
SAN. SEWER SIZE % GR. LOC.
SAN. MH. CAST. ELEV. INV. ELEV.
SAN. CONN. SIZE, LOC. DEPTH
STORM SEWER SIZE % GR. LOC.
STORM MH. CAST ELEV. INV. ELEV.
PAV'T TYPE GRADE CURBS
GAS LINE LOC. SIZE PRESSURE
SEPTIC TANK LOCATION & DUPLICATION AREA
WELL LOCATION
ISOLATION RADIUS FROM WELL

REVISIONS		
NO.	DATE	BY
1		
2		
3		
4		
5		

PLAN PREPARED BY:

DEBEVEC • SALO & ASSOCIATES, INC.

125 E. ERIE ST. PAINESVILLE, OHIO

DRAWN BY K.K.	SCALE 1" = 30'	PHONE NO.	352-9250
CHK'D.	DATE JAN 30, 1979	DRAWING NO.	3226-36
CREW CHIEF	APP'D.		

"AS BUILT" CERTIFICATION

I, HEREBY CERTIFY THAT THE CIRCLED GRADES ARE EXISTING FINISH GRADES CHECKED IN THE FIELD ON _____, 19____ AND ARE CORRECT TO THE BEST OF MY KNOWLEDGE AND BELIEF.

REGISTERED SURVEYOR REG. NO.

Grading Plan Approved as shown and/or noted
THOMAS P. GILLES, P.E.
Lake County Engineer
By _____ Date 3-6-79

NORTH

WHISTLEWOOD WAY 60'

CASTLEWOOD COURT 60'

Benchmark - Top of hydrant in front of S½ 39 & S½ 40. Elevation - 695.11

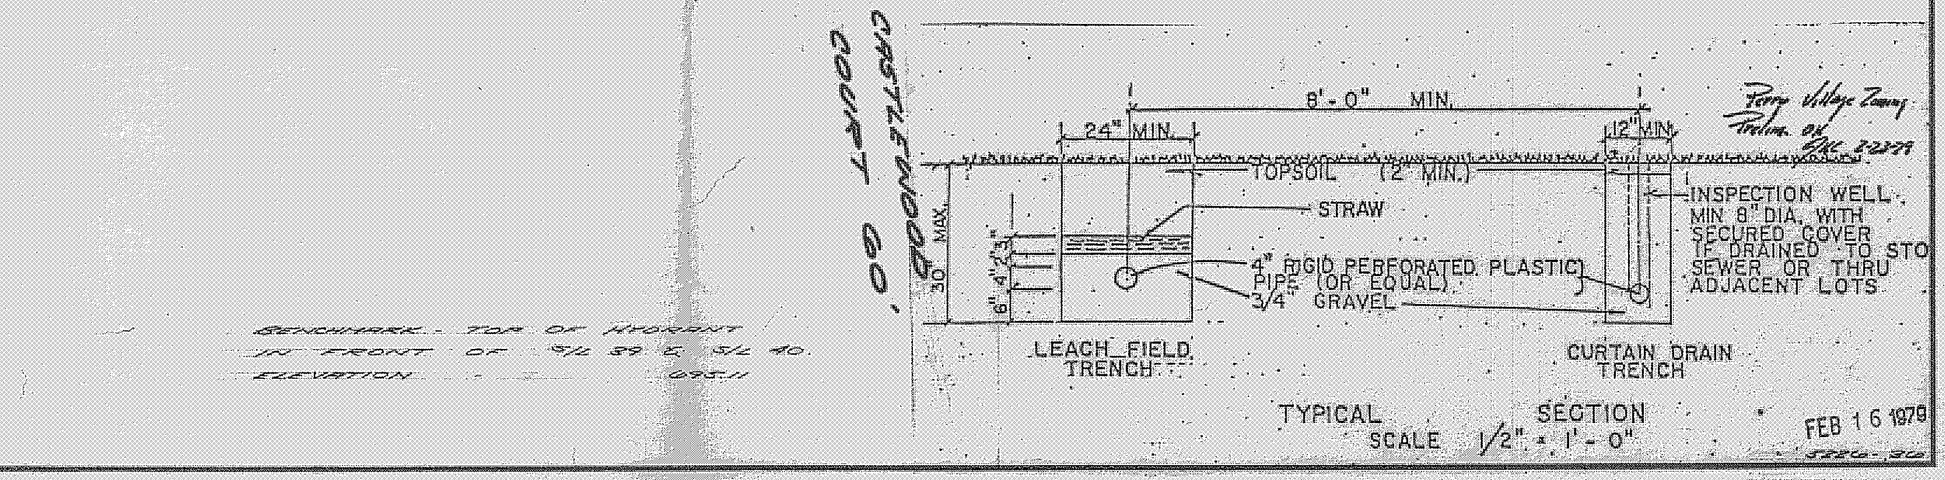

Perry Village Zoning Insp. OK 3-2-79

TYPICAL SECTION
SCALE 1/2" = 1'-0"

FEB 16 1979

3226-36