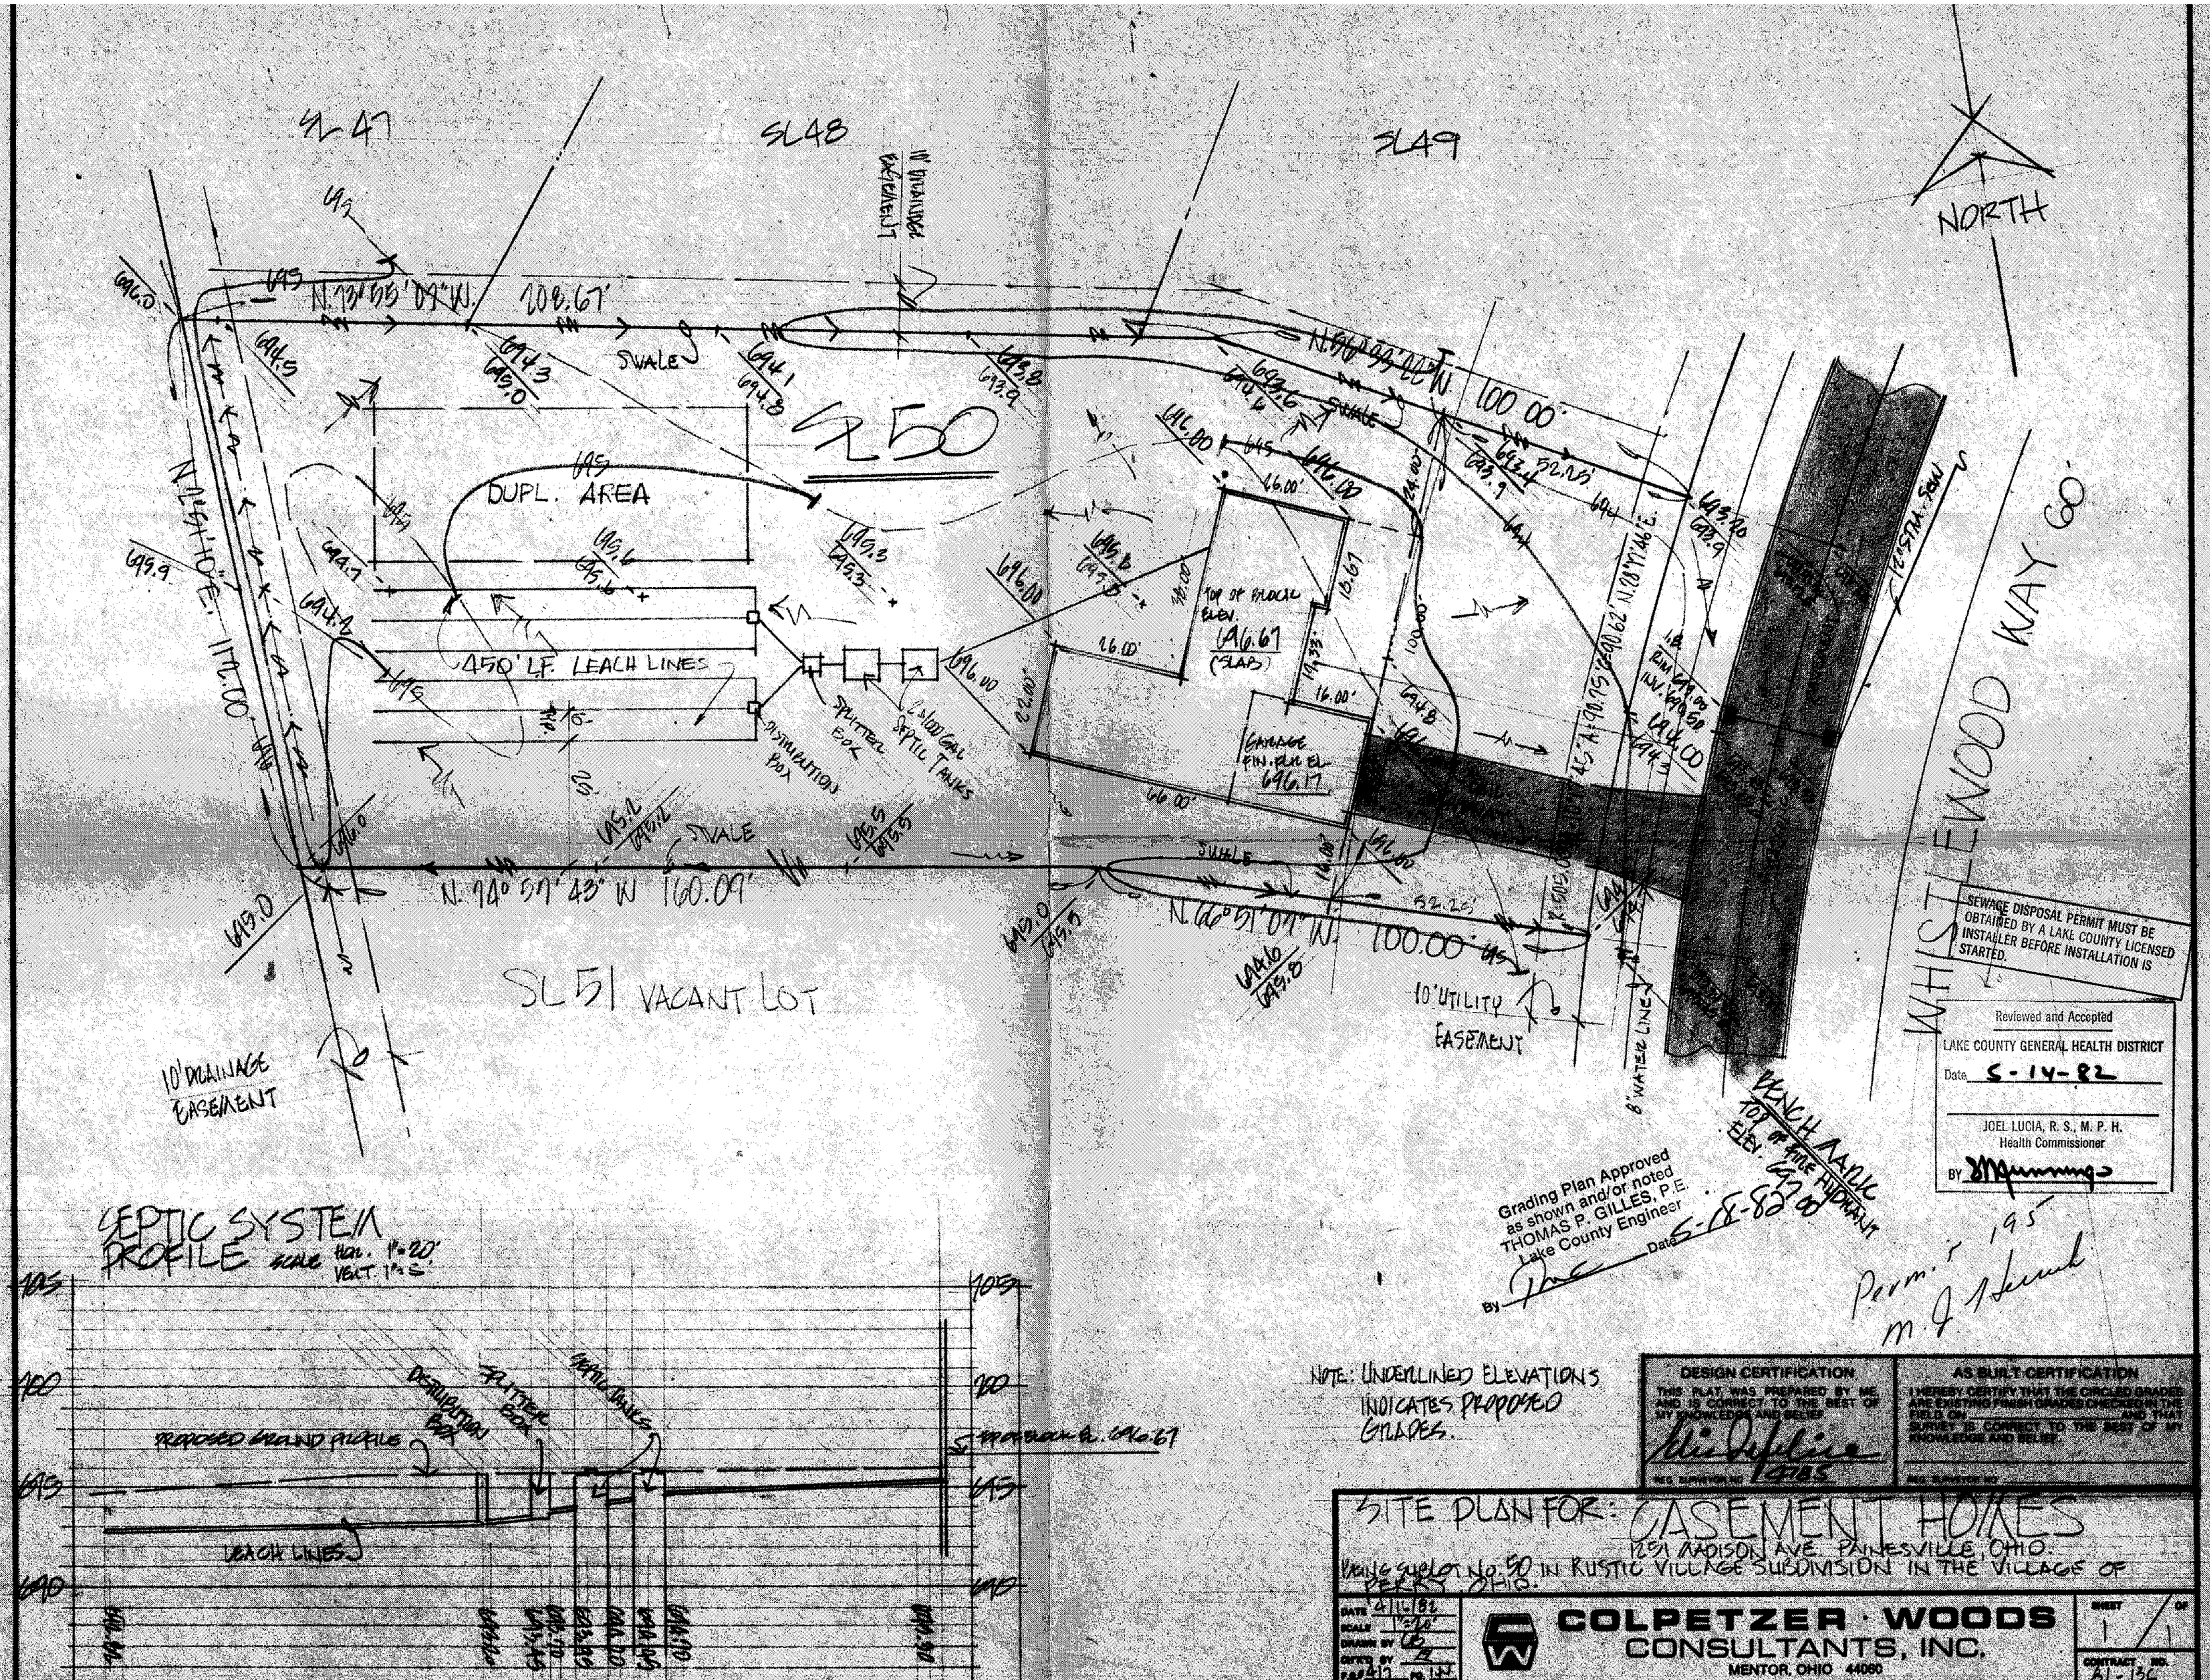

SEWAGE DISPOSAL PERMIT MUST BE OBTAINED BY A LAKE COUNTY LICENSED INSTALLER BEFORE INSTALLATION IS STARTED.

Reviewed and Accepted
LAKE COUNTY GENERAL HEALTH DISTRICT
Date 5-14-82
JOEL LUCIA, R. S., M. P. H.
Health Commissioner
BY [signature]

Grading Plan Approved as shown and/or noted
THOMAS P. GILLES, P.E.
Lake County Engineer
By [signature] Date 5-18-82

Permit 195
M. J. [signature]

NOTE: UNDERLINED ELEVATIONS INDICATES PROPOSED GRADES.

DESIGN CERTIFICATION	AS BUILT CERTIFICATION
THIS PLAT WAS PREPARED BY ME AND IS CORRECT TO THE BEST OF MY KNOWLEDGE AND BELIEF. [signature] REG. SURVEYOR NO. 4785	I HEREBY CERTIFY THAT THE CIRCLED GRADES ARE EXISTING FINISH GRADES CHECKED IN THE FIELD ON _____ AND THAT SURVEY IS CORRECT TO THE BEST OF MY KNOWLEDGE AND BELIEF. REG. SURVEYOR NO.

SITE PLAN FOR: CASEMENT HOMES
1251 MADISON AVE. PAINESVILLE, OHIO.
BEING SUBLOT NO. 50 IN RUSTIC VILLAGE SUBDIVISION IN THE VILLAGE OF PERRY, OHIO.

DATE 4/16/82
SCALE 1"=20'
DRAWN BY [illegible]
CHK'D BY [illegible]
F.B.# 417 PG. 1[illegible]

COLPETZER · WOODS CONSULTANTS, INC.
MENTOR, OHIO 44060

SHEET 1 OF 1
CONTRACT NO. 81-136