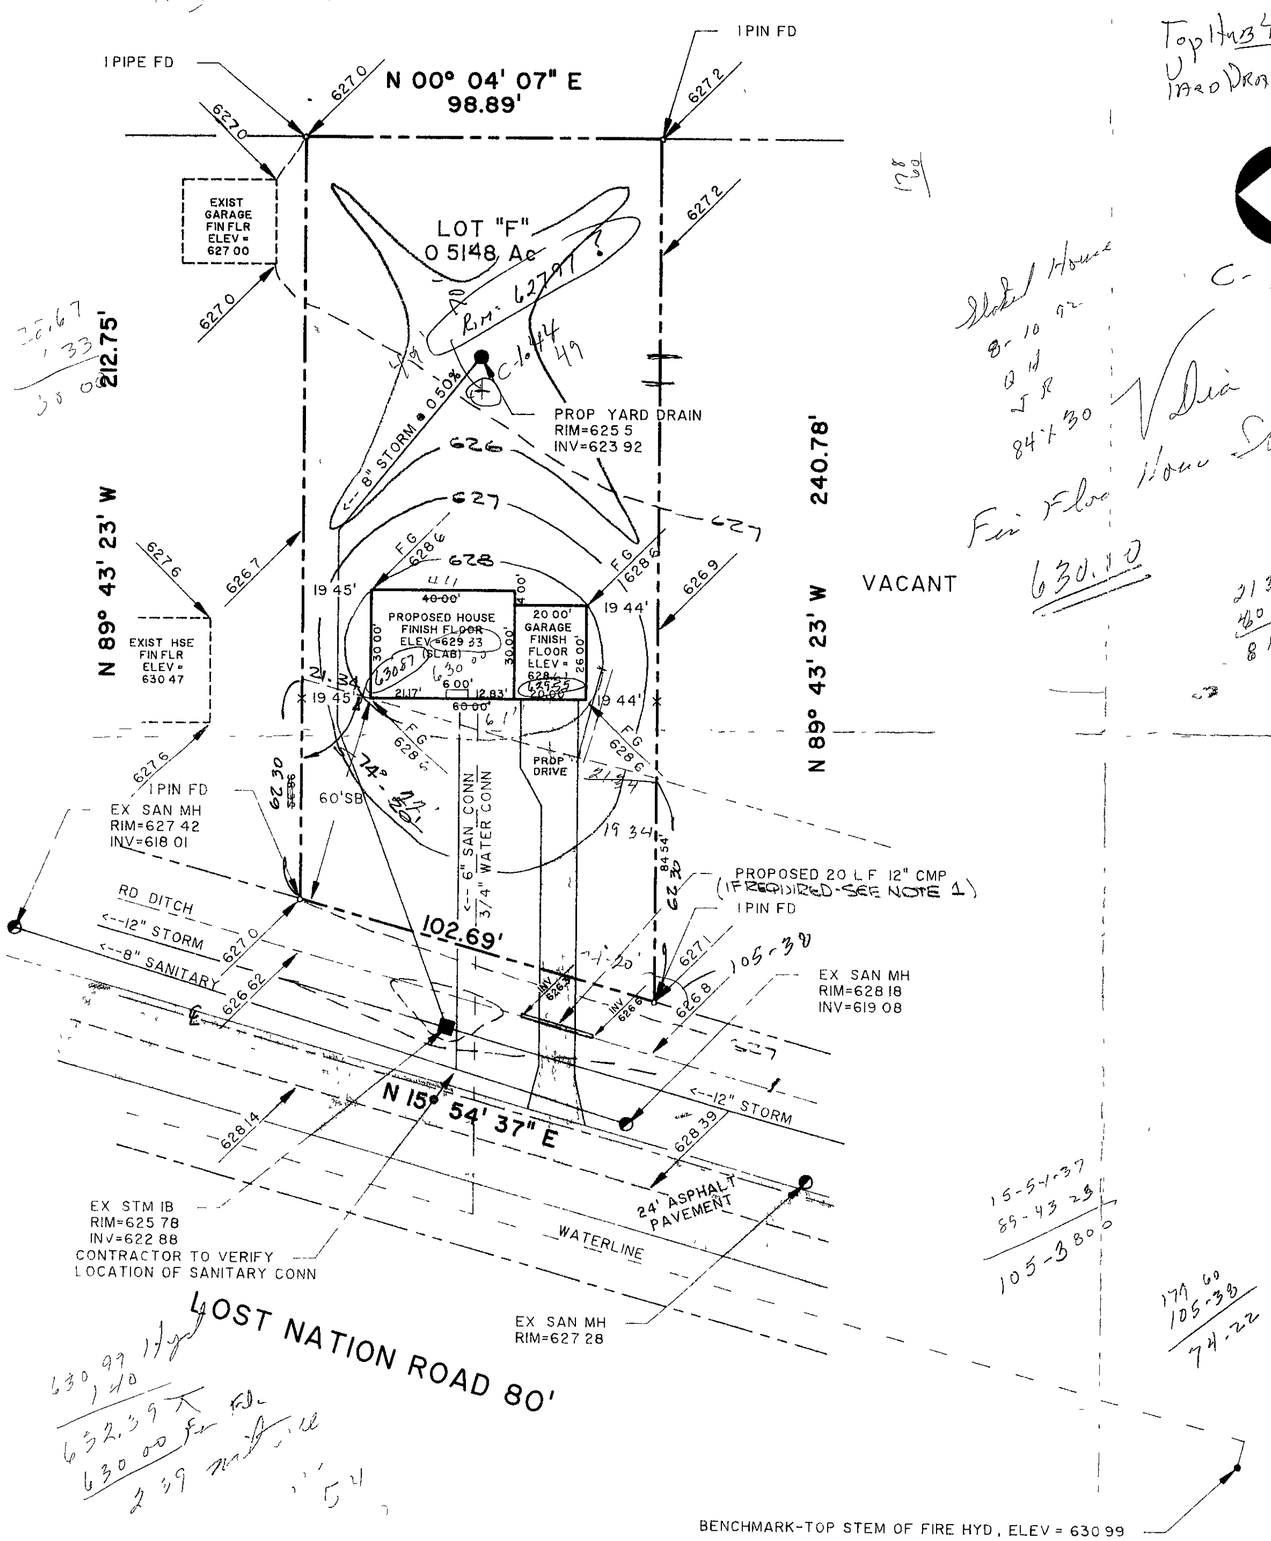

GENERAL NOTES:

1 GRADING AND DRIVE ACESS TO MATCH EXISTING CONDITIONS WITHIN THE RIGHT-OF-WAY OF LOST NATION ROAD
2 DRIVEWAY APRON TO BE 6" THICK
3 ALL DOWNSPOUTS TO BE CONNECTED TO STORM CONNECTION
4 BENCHMARK - TOP STEM OF FIRE HYDRANT LOCARED 130'± SOUTH ON LOST NATION, ELEV = 630 99

LEGEND

	EXISTING CONTOUR PROPOSED CONTOUR
100 00 / 100 00	EXISTING ELEVATION PROPOSED ELEVATION
o	DOWNSPOUT LOCATION

CERTIFICATION

"I THE UNDERSIGNED HEREBY CERTIFY THAT THIS TOPOGRAPHY INDICATED BY 1' CONTOURS AND ELEVATIONS SHOWN HEREON REPRESENTS AN ACTUAL SURVEY MADE BY ME ON THE 26th DAY OF JUNE , 1992 AND THE ELEVATIONS WERE TAKEN AT APPROPRIATE INTERVALS AND AS OF THAT DAY THEY EXISTED AS INDICATED HEREON

"I HEREBY CERTIFY THAT THIS PLAN WAS PREPARED BY ME AND IS CORRECT TO THE BEST OF MY KNOWLEDGE"

QUENTIN S HIMEBAUGH, P S No 6820

"AS-BUILT"

PROPOSED FINISH FLOOR OF HOUSE = _____
"AS-BUILT" TOP OF BLOCK = _____
"AS-BUILT" FINISH FLOOR OF HOUSE = _____

"I HEREBY CERTIFY THAT THE "AS-BUILT" GRADE WAS CHECKED IN THE FIELD ON THE __ DAY OF _____, 19__ "

QUENTIN S HIMEBAUGH P S No 6820

PREPARED BY:

Himebaugh and Associates
Surveyors and Site Consultants
38083 West Spaulding St
Willoughby, Ohio 44094
(216) 946-1761

SITE PLAN: LOT F-0 5148 Ac , LOCATED 336 78' NORTH OF WOOD RD 60'
CITY OF WILLOUGHBY, LAKE COUNTY, OHIO

PREPARED FOR	BIRCHFIELD HOMES, INC
SCALE	1" = 30'
DATE	JULY 01, 1992
DRAWN BY	DAVID W NOVAK

92-068-F

FORM No E-004 (11/21/91)