LAND SCHEDULE FOR SHEET NO 25

114.4 Map No 26(1)

Parcel No.	Custodian's No.	Kind of Instrument	Date of Instrument	Grantor	Grantee	Book	Page	Date	Acres	Square Feet	Remarks
1											For easement for highway purposes, see Cust. No. 840. Same as Parcel No 35, Map No 24.
2	607	War. Deed	Oct.20 1902	Ann M. Carson, et al.	PP&FRy	33	507	Mar.17 1903	2.68		Orig. Area=4.480Ac. Retired 0.160Ac. See note "A". For easement for highway purposes, see Cust. No. 840. Sold 1.64Ac. See Cust No. 849
3	608	War. Deed	Mar.17 1893	Horace Alvord, et ux	PP&FRy	21	164	May 23 1893		30950	For easement for highway purposes, see Cust. No. 840
4	609	War. Deed	Oct.20 1902	E.Wickland, et ux	PP&FRy	33	510	Mar.11 1903	3.475		Orig. Area=5.51Ac. Retired 0.682 Ac. in Richmond Ave & Fairport Rd. not allowed in inventory. Retired 0.078 Ac. See Note "A". For easement for highway purposes, see Cust. No. 840. 1.325 Ac. sold. See Cust. No. 851.
5	610	War. Deed	Mar.18 1902	Z.S.Wilson, et ux.	PP&FRy	33	238	Mar.31 1902	13.439		Orig. Area=14.58Ac. Retired 1.124Ac. in Richmond Ave. & Fairport Rd. not allowed in inventory. Retired 0.017Ac. See cust. No. 692 A.F.E.= For easement for highway purposes, see Cust. No. 840.
6	618	Q.C. Deed	Feb. 3 1860	Harvey Cram, et ux.	P&HRR	4	5	Aug.13 1872		24700	This instrument also covers Parcels No.6 and 35, Map No 24.
	606	War. Deed	June30 1880	L.C.Brown et ux	P&YRy	10	180	Aug.27 1880			This instrument also covers Parcel No.7. Subject to all legal highways. 5250 sq.ft. occupied by Richmond Rd.
7										4720	2900 sq.ft. occupied by Richmond Rd. Same as last instrument under Parcel No.6.
8	616	War. Deed	Mar.6 1863	Moses Morrell et ux, et al.	Harvey Cram	U	198	May 12 1864	1.67		14400 sq.ft. occupied by Richmond Rd.
9	617	Agreement	Apr.26 1855	Geo.E.Paine	P&HRR				1.05		Agreement to convey by War.Deed. Record of deed not found.
10	619	War. Deed	Aug. 1 1889	Louis H.Gunther	PP&FRy	18	180	Sep 24 1889	7.16		Instrument also covers Parcels No 42, 43 and 44
11	620									15700	Record not found. Claimed on account of owning all adjacent property.
12	621	War. Deed	Jan.26 1916	Ida A.White	B&ORR	59	478	Mar.14 1916	9.913		Orig. Area=12.14Ac. Retired 0.812Ac. in Fairport Rd. & 0.172Ac. in River not allowed in inventory. Retired 0.20Ac. See Note "A". Retired 1.343Ac. see cust. No. 692 A.F.E.=
13	622									12000	Record not found.
14	623	War. Deed	June 9 1856	A.Thorp, et ux.	P&HRR	Z	553	Mar.19 1872		41460	Instrument reserves a tax title of 10 rods in lots 19 and "SF" held by H.Holbrook or some other person. Subject to all legal highways.
15										16200	Record not found. Conveyance of adjoining property recognize R.R. R/W as claimed.
16	624	War. Deed	Dec.15, 1858	D.W. Slocum, et ux	Harvey Cram	U	196		2.10		Orig. Area=5.73Ac; Retired 3.63Ac.
	696	War. Deed	Oct.8, 1956	The Cleveland Trust Co.	B.&O.R.R.						Subject to an easement for a Pipe Line, also covers Parcel No.111 map S-25a. A.F.E.=44285
17									1.05		Record not found. Conveyance of adjoining property recognize R.R. R/W as claimed.
18	625	War. Deed	Feb.18 1907	Elizabeth Gibson, et vir.	PP&FRy.	39	417	Mar.12 1907		1375	
19	626	War. Deed	Feb.13 1907	C.J.Scott, et ux.	PP&FRy.	39	418	Mar.12 1907		1500	
20	637	War. Deed	Jan.5 1907	Daniel Hayes, et ux.	PP&FRy.	39	386	Jan.25 1907		2500	
21	638	Q.C. Deed	Feb.13 1907	C.J.Scott, et ux.	PP&FRy.	42	362	Mar.12 1907	1.29		
22	639	War. Deed	Mar.12 1857	Harvey Abel, et ux.	Harvey Cram.	44	637	Oct.11 1909	4.33		Subject to all legal highways.
23	640	War. Deed	Aug.17 1880	D. Barclay, et ux.	P&YRy.	10	185	Aug.28 1880	1.32		Subject to all legal highways.
24	641									3400	Record not found.
25	616	Q.C. Deed	June15 1889	M.Morrell.	PP&FRy.	22	441	Sep.26 1892		34,050	Area changed due to error in plotting.
26	643	Q.C. Deed	June10 1889	Sarah E.Ludlum, et vir, et al.	PP&FRy.	22	440	Sep.26 1892		34,600	Maria St. vacated. See Cust. No. 679. For easement for roadway purposes, see Cust. No. 843.
27	644	Q.C. Deed	June24 1889	A.E.Powers, et al, Trsts.	PP&FRy.	22	442	Sep.26 1892		7350	Instrument also covers Parcels 30 & 112. Contains reversionary clause. For easement for roadway purposes, see Cust. No. 843.
28	645	War. Deed	June29 1886	J.W.Averill, et ux.	PP&FRy.	15	480	Jan.27 1887		3550	Subject to all legal highways. For easement for roadway purposes, see Cust. No. 843.
29	646	Petition	Mar.8,48	G.Everitt		F	293			2450	Record not found - Hollon St. Shows Hollon St. as open street.
30										3050	Same instrument as Parcel No. 27.
31										1900	Lands not owned but easement inferred from Railroad ownership of track. Area based on arbitrary width of 16 ft.
32	647	Ordinance	June16 1891	Village of Richmond	PP&FRy.					17038	Lands used but not owned. Ordinance grants the right to the use of part of River St.
33	648	Ordinance	Apr. 11,1916	Village of Richmond	B.&O.R.R.					1520	Lands used but not owned. Grants right to use part of River St.
		Decree	Nov.24,1925	Village of Richmond vs B&O.R.R. et al		Journal Entry-Ct of Common Pleas.					Dissolving injunction against R.R. filed by Village to restrain R.R. from placing tracks in River St.
34	649									1900	Record not found - Henry St.
~~35~~	~~681~~	~~Ordinance~~	~~Apr.27,39~~	~~Village of Richmond~~		~~Ordinance No.161~~				~~16112~~	~~Vacating portion of River St.~~ See Note "B".
~~36~~	~~662~~	~~War. Deed~~	~~Mar. 1895~~	~~Z.S.Wilson, et ux, et al.~~	~~Joseph Chapman~~	~~24~~	~~609~~	~~Apr.12 1895~~		~~3650~~	~~Subject to all legal highways.~~
	668	~~Deed~~	~~June27 1903~~	~~Joseph Chapman~~	~~PP&FRy.~~	~~33~~	~~595~~	~~Jul.21 1903~~			~~Blanket Deed. Instrument also covers Parcels No. 37,38,39 and 40.~~ See Note "B".
~~37~~	~~663~~	~~Q.C. Deed~~	~~June 6 1891~~	~~J.W.Averill~~	~~Joseph Chapman~~	~~20~~	~~298~~	~~Jul.23 1891~~		~~3650~~	~~Also covered by last instrument under Parcel No. 36.~~ See Note "B".
	~~664~~	~~Q.C. Deed~~	~~Oct.20 1891~~	~~Horace Steele, et ux.~~	~~Joseph Chapman~~	~~22~~	~~135~~	~~Mar.28 1892~~			
~~38~~	~~665~~	~~War. Deed~~	~~Mar.26 1895~~	~~C.C.Child, et ux, et al.~~	~~Joseph Chapman.~~	~~21~~	~~459~~	~~Apr.12 1895~~		~~1825~~	~~Also covered by last instrument under Parcel No. 36.~~ See Note "B".
~~39~~	~~666~~	~~War. Deed~~	~~Mar.26 1895~~	~~J.B.Burrows, et ux.~~	~~Joseph Chapman~~	~~21~~	~~458~~	~~Apr.12 1895~~		~~1825~~	~~Also covered by last instrument under Parcel No. 36.~~ See Note "B".
~~40~~	~~667~~	~~War. Deed~~	~~Mar.25 1895~~	~~A.E.Powers, Trst. et ux.~~	~~Joseph Chapman~~	~~24~~	~~608~~	~~Apr.12 1895~~		~~2750~~	~~Also covered by last instrument under Parcel No. 36.~~ See Note "B".
41											This parcel number not used.

Note: "A" Area changed due to error in plotting. No Authority.
Note: "B" Property leased to Staley Mfg. Co. and subsequently sold to same party. See Cust. No. 681.

I-OH 114.4(26)

LAND SCHEDULE FOR SHEET NO. 25

114.4 Map 26(4)

Parcel No.	Custodian's No.	Kind of Instrument	Date of Instrument	Grantor	Grantee	Book	Page	Date	Acres	Square Feet	Remarks
58										9350	Same instrument as Parcel No. 57 & 2nd instrument under Parcel No. 53. See Note "A". Orig. Area=12700 sq.ft. 1700 sq.ft. deleted due to error in Plotting. Retired 1650 sq.ft. to form new Parcel No. 107. A.F.E.=45053.
59										720	Same as last instrument under Parcel No. 53 and instrument under Parcel No. 55.
60	703	Q.C. Deed	May 14 1906	F. Alvord, et ux.	PP&FRy.	41	388	May 25 1906		9800	Also covered by instrument for Parcel No. 103. Instruments also cover Parcels No.61 and 62. Subject to a 20ft. easement thru this Parcel.
	704	Q.C. Deed	June23 1908	Margaret L. Aiken, et vir.	PP&FRy.	45	79	Jul.14 1908			
	705	Q.C. Deed	June24 1908	Fred Manger.	PP&FRy.	45	80	Jul.14 1908			
61	706	War. Deed	Jul.16 1901	M.C.Mighton, et ux, et al.	PP&FRy.	33	32	Sep.12 1901		20	Also covered by instrument under Parcel No.103, and instruments under Parcel No.60. Instrument also covers Parcels No.64,65,68 69,70 and 73. Quit Claims all interest in the Old Plank Road from its center line to the West line of lots 258 and 259.
62										40	Same instruments as Parcels No.103 and 60.
63	707	Q.C. Deed	Apr.12 1906	A.Hine, et ux.	PP&FRy.	41	389	May25 1906		4500	Also covered by instruments under Parcel No.57. This instrument Quit Claims a 1/6 interest in this Parcel and Parcels No. 64 and 65.
64										3200	Same instruments as Parcels No.57,61 & 63.
65										5800	Same instruments as Parcels No.57,61 and 63 and last instrument under Parcel No.53.

LAKE CO. OHIO.
PAINESVILLE TWP.

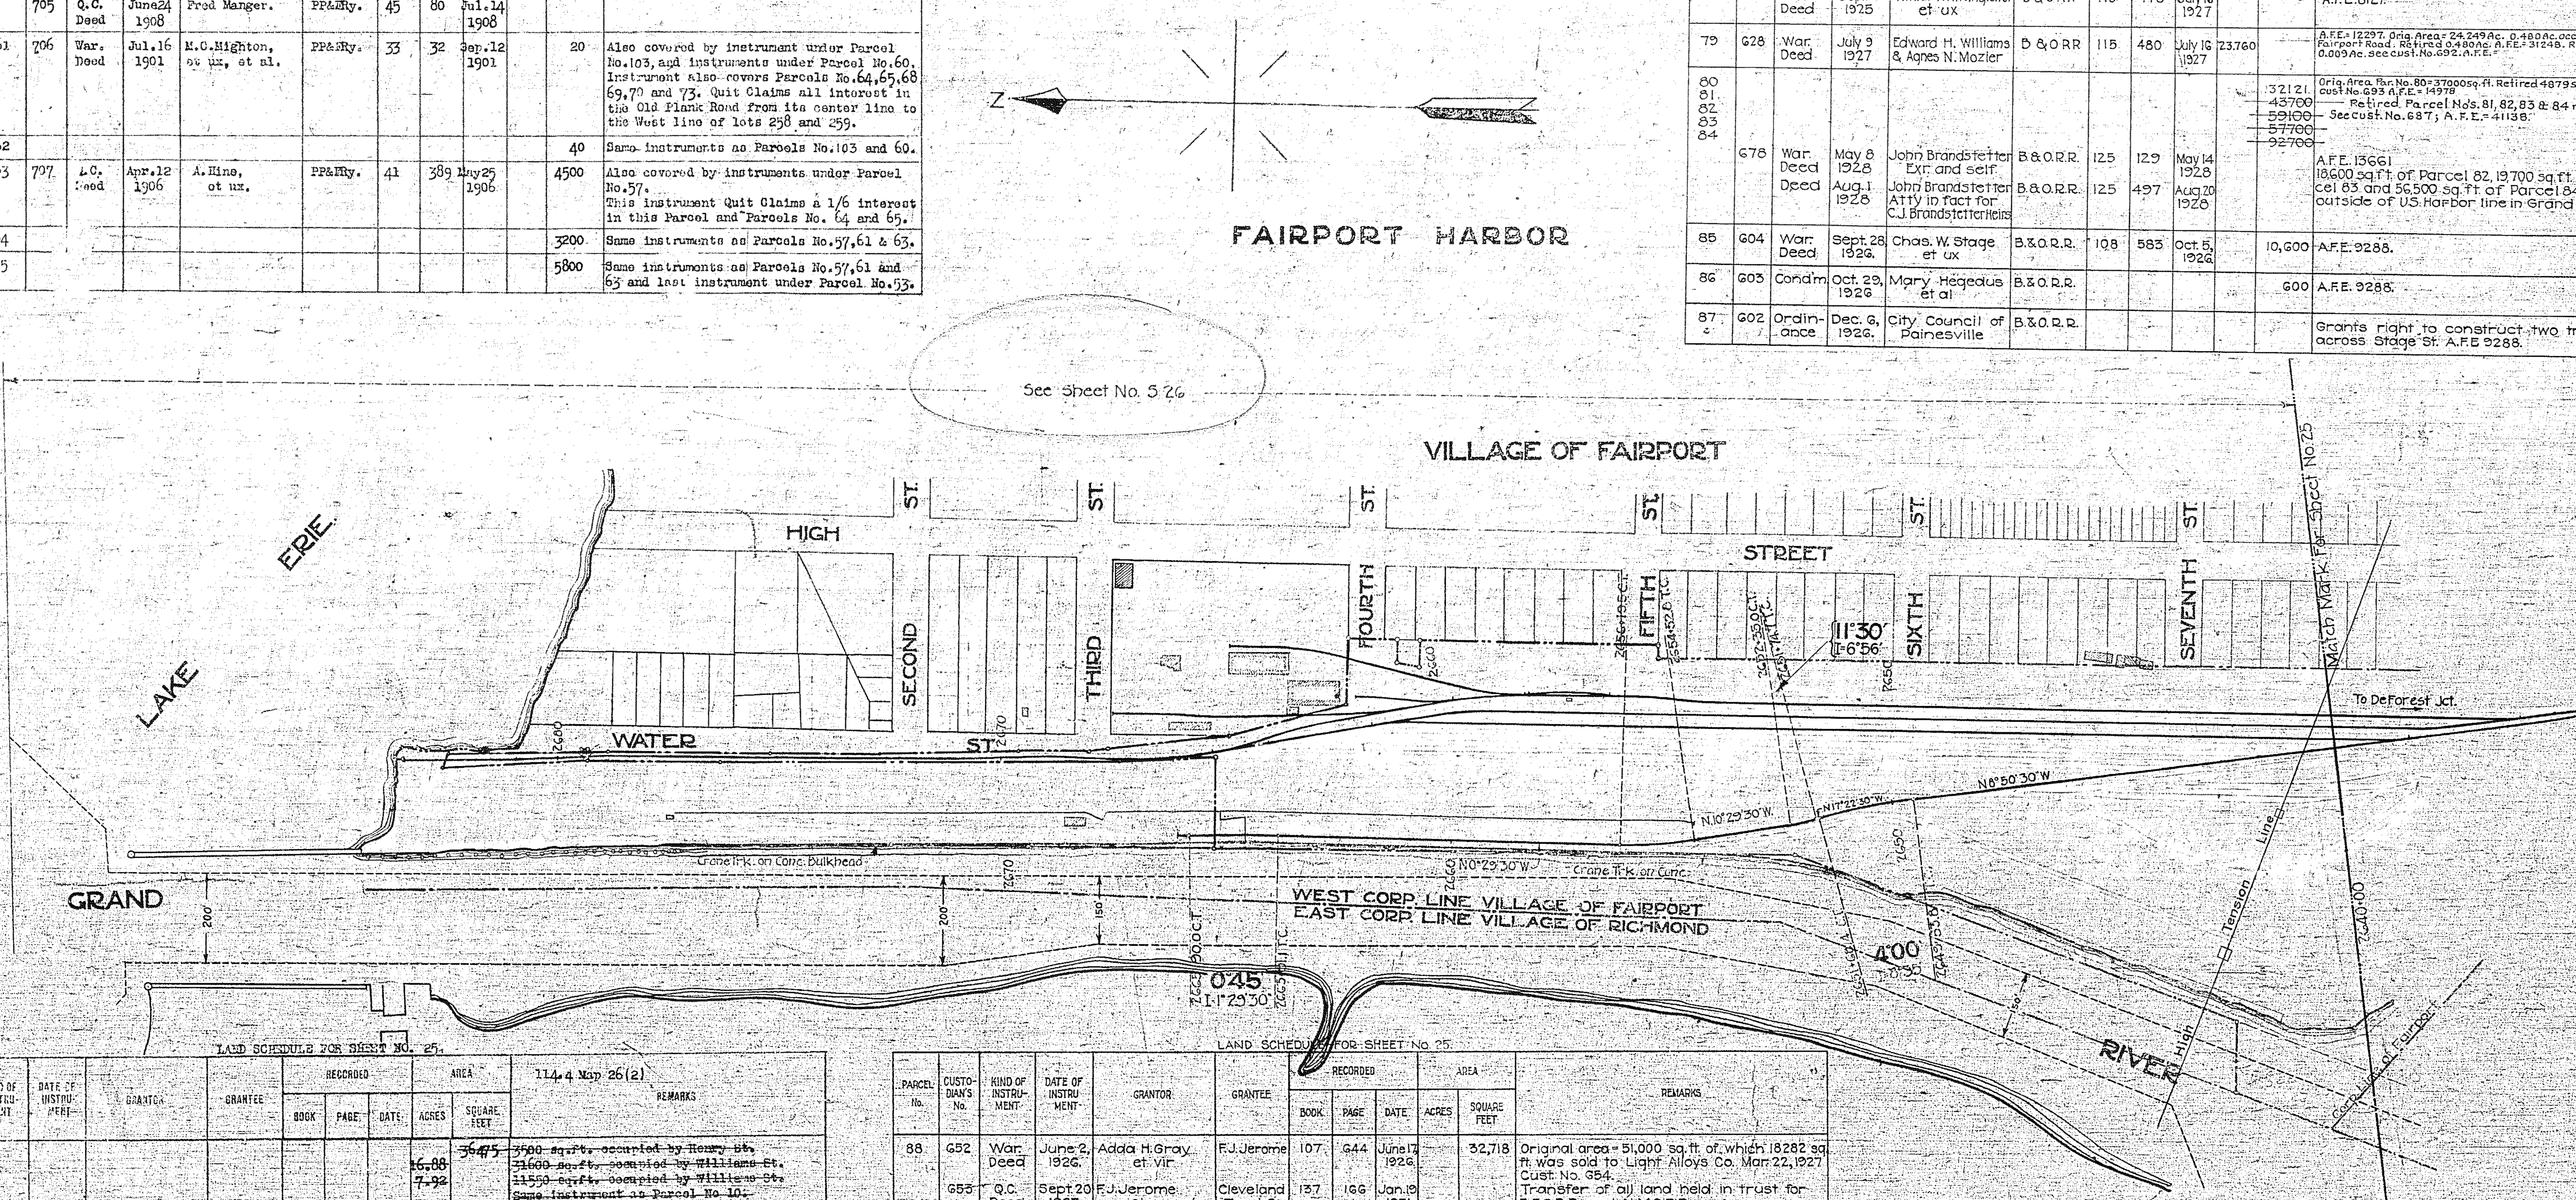

LAND SCHEDULE FOR SHEET No.25.

114.4 Map 26 (6)

Parcel No.	Custodians No.	Kind of Instrument	Date of Instrument	Grantor	Grantee	Book	Page	Date	Acres	Square Feet	Remarks
~~74~~	~~660~~	~~War. Deed~~	~~Oct.21 1925~~	~~Mark D. Webster et ux~~	~~B&ORR~~	~~102~~	~~286~~	~~Oct.22 1925~~		~~900~~	~~A.F.E. 8519.~~ See Note "B".
75	473	~~Lease to Co.~~	~~Sept.3, 1935~~	~~New York Central R.R. Co.~~	~~B&ORR~~					59,251	~~Renewable annually.~~ Cancelled, AFE 44285
76 77 78									2.419 3.806 9.312		Orig. Area Par. 76=4.339Ac. 0.640Ac. occupied by Fairport Road etc. Retired 0.482Ac. of Public Rd. A.F.E.=31248. Retired 0.158Ac. of Public Rd. see cust. No. 648. Retired 1.28Ac. see cust. No. 692. A.F.E.= Orig. Area Par. 78=9.575Ac. 0.153Ac. occupied by Fairport Rd. Retired 0.153Ac. A.F.E.=31248. Retired 0.110Ac. see cust. No. 692 A.F.E.=
	627	War. Deed	July 14 1925	W. R. Radcliffe, Tr. et ux	Wm. E. Whittington Jr.	101	429	July 17 1925			Subject to L.S. & M.S. Ry. pipe line easement dated Oct.9, 1913. Pipe line has been removed.
		War. Deed	Sept.4 1925	Wm. E. Whittington Jr et ux	B&ORR	115	478	July 16 1927			A.F.E. 8127.
79	628	War. Deed	July 9 1927	Edward H. Williams & Agnes N. Mozier	B&ORR	115	480	July 16 1927	23.760		A.F.E.=12297. Orig. Area=24.249Ac. 0.480Ac. occupied by Fairport Road. Retired 0.480Ac. A.F.E.=31248. Retired 0.009Ac. see cust. No. 692. A.F.E.=
80 81 82 83 84										32121 ~~43700~~ ~~59100~~ ~~57700~~ ~~92700~~	Orig. Area Par. No. 80=37000 sq.ft. Retired 4879 sq.ft. see cust. No. 693 A.F.E.=14978. Retired Parcel No's. 81, 82, 83 & 84 map S-25b. See cust. No. 687; A.F.E.=41138.
	678	War. Deed	May 8 1928	John Brandstetter Exr. and self	B&O.R.R.	125	129	May 14 1928			A.F.E. 13661 18,600 sq.ft. of Parcel 82, 19,700 sq.ft. of Parcel 83 and 56,500 sq.ft. of Parcel 84 lie outside of U.S. Harbor line in Grand River.
		Deed	Aug.1 1928	John Brandstetter Atty in fact for C.J. Brandstetter Heirs	B&O.R.R.	125	497	Aug.20 1928			
85	604	War. Deed	Sept.28 1926	Chas. W. Stage et ux	B.&O.R.R.	108	583	Oct. 5, 1926		10,600	A.F.E. 9288.
86	603	Cond'm.	Oct. 29, 1926	Mary Hegedus et al	B.&O.R.R.					600	A.F.E. 9288.
87	602	Ordinance	Dec. 6, 1926.	City Council of Painesville	B.&O.R.R.						Grants right to construct two tracks across Stage St. A.F.E 9288.

LAND SCHEDULE FOR SHEET NO. 25

114.4 Map 26(3)

Parcel No.	Custodian's No.	Kind of Instrument	Date of Instrument	Grantor	Grantee	Book	Page	Date	Acres	Square Feet	Remarks
53	673	War. Deed	Apr.20 1876	Daniel Hayes, et ux.	PP&FRy.	9	563	Feb.17 1880	1.950		Orig. Area=3.02Ac. Add 0.15Ac. & 0.003 Ac. due to error in Plotting. This instrument also covers Parcels No.54 and 55. All of these parcels were leased to C.S.Wight for 99 years who assigned his leasehold interest to the P&F Terminal Co. who in turn released their interest to the P&LE Dock Co. which lease was cancelled. F.P.&E.R.R. has easement across this parcel.
	674	Agreement	Dec.19 1874	Co.Comm. of Lake County.	P&YRR	B 57 Lake Co.Comm. Journal.					21300 sq.ft. occupied by Fairport Road. This instrument also covers Parcels No. 55,57,58,59,65 and 69 this Map and probably the greater part of Parcels No.4,8, 14,16,22,25 and 37; and Parcels No. 52,53, 99 and 103, Map No. 26. Carrier granted right to use 25 ft. in the center of Water St. from its northerly terminus to the south line of Fourth St. All of the Old Plank Road from the south line of Fourth St. to High St. except 16 ft on east side and if any portion of Old Plank Road south of High St. is used carrier to dedicate sufficient land on the east side to construct new road. See cust. 675
	676	Lease	Jul. 1,1921	P.& F. Terminal Co.	B.&O.R.R.						This instrument quit claims Parcels No's. 53, 54 and 55 and conveys fee title to Parcel No. 67. A.F.E. 7237. (See Note "A")
	676	War.Deed	Oct. 1,1924	P.& F. Terminal Co.	B.&O.R.R.						Conveys leasehold title to Par. No's. 53, 54 & 55. A.F.E. 7237.
	676	Assignment	Oct. 1,1924	P. & F. Terminal Co.	B&O.R.R.						Retired 0.194Ac. See cust. No. 693. A.F.E.=14978. Retired 1.029Ac. to form new Par. No. 105 A.F.E.=45053
	676	Bill of Sale	Oct. 1,1924	P. & F. Terminal Co.							
54									0.074		6/30/18 area=6.56Ac. of which 1.07Ac. was sold under A.F.E. 10450. Same as inst. under Cust. No. 673 and 676 under Parcel 53. Retired 5.416 Ac. see cust. No. 693 A.F.E.=45053
55	615	Order	Mar. 3, 1914	Co. Comm. of Lake County.	PP&FRy.					350	Also covered by instruments for Parcel No. 53. Instrument also covers Parcels No. 56, 57, & 59. County Commissioners vacate these parcels.
56	675	War. Deed	Jan.10 1913	M.C.Mighton, et al.	PP&FRy.	54	90	Mar.12 1913		7750	To be used for road change. See Order under Parcel No. 55 requiring land for road change.
57	701	Q.C. Deed	Mar.14 1906	H.Bacon and M.G.Norton, exec.	PP&FRy.	39	166	May 25 1906		7771	Orig. Area=8200 sq.ft. This instrument Quit Claims entire interest in Parcels No. 57 and 58 and conveys fee simple title to a 1/6 interest in Parcels No. 63, 64 and 65.
	702	Q.C. Deed	Apr.6 1906	Mary R.Paine, in person as executrix	PP&FRy.	39	165	May 25 1906			This instrument also covers Parcels No.58, 63, 64 and 65. These instruments are subject to a 33 ft. easement across Parcels No.57 and 58. Also covered by Agreement, Cust. No. 674 under Parcel No. 53, and instrument under Parcel No. 55. Retired 429 sq.ft. to form new Parcel No. 108 A.F.E.=45053

LAND SCHEDULE FOR SHEET NO. 25

114.4 Map 26(5)

Parcel No.	Custodian's No.	Kind of Instrument	Date of Instrument	Grantor	Grantee	Book	Page	Date	Acres	Square Feet	Remarks
66	709	~~Lease~~	~~May18 1912~~	~~P&LE Dock Co.~~	~~B&OHR~~						~~Same as Parcel No. 2, Map No. 26. Instrument also covers Parcel No. 71 this Map and various Parcels on Map No. 26.~~ P&LE Dk Co. owns the fee in Par Nos. 66 & 71.
	688	Q.C. Deed	July 17, 1954	Penna. & Lake Erie Dock Co.	B.&O.R.R.				9.63		All rights, title & interest in Part of Parcel No's. 4 & 23 all rights in Parcel No's. 1, 2, 3, 5, 6, 7, 8, 9, 10, 11, 12, 13, 14, 15, 16, 17, 18, 19, 20, 21, 22 map 26 & Parcel No's. 66, 71, 72 & 73 map 25. A.F.E.=
67	676	War. Deed	Oct. 1, 1924.	Pittsburg & Fairport Terminal Co.	B&O.R.R.	93	492	Oct.7 1924	11.28		Conveys fee title to the parcel and quit claims Parcels Nos. 53, 54 and 55. See A.F.E. 7237. Same as Parcel No.1, Map No.26.
68										1000	Same instrument as Parcel No. 61.
69										2600	Same instrument as Parcel No. 61 and last instrument under Parcel No. 53.
70										3927	Same instrument as Parcel No. 61.
71	710	~~Lease~~	~~Nov.29, 1949~~	~~P&LE Dock Co. (Lessor)~~	~~B.&O.R.R. (Lessee)~~	Lease 5	Records 207		5.03		Same as Parcel No. 3, Map No. 26.
	688	Q.C. Deed	July 17, 1954	Penna. & Lake Erie Dock Co.	B.&O.R.R.				5.03		Also covered by instruments for Parcel No. 66. Original Area 5.29 Ac.; 0.26 Ac. retired due to cancellation of Lease July 31, 1906. A.F.E. 39248.
72	720	Q.C. Deed	Aug.7 1901	James H.Taylor, Trustee.	PP&FRy.	32	571	Oct.3 1901		2500	
	720	War. Deed	Aug.10 1901	Horace Alvord, et ux.	PP&FRy.	32	570	Oct.3 1901			Subject to all legal highways. Also covered by 2nd Instrument in Parcel No. 66.
	720	Q.C. Deed	Aug.13 1901	B.F.Crofoot, et ux.	PP&FRy.	32	572	Oct.3 1901			
	720	Q.C. Deed	Aug.16 1901	Catharine W. Spiwok, et al.	PP&FRy.	32	573	Oct.3 1901			
	720	Q.C. Deed	Aug.16 1901	Robert Foster, Trustee.	PP&FRy.	32	574	Oct.3 1901			
	720	Q.C. Deed	Aug.23 1901	The L.Schlather Brewing Co.	PP&FRy.	32	575	Oct.3 1901			
	720	Q.C. Deed	Aug.24 1901	J.J.Foster, et ux.	PP&FRy.	32	576	Oct.4 1901			
	720	Q.C. Deed	Aug.24 1901	C.H.Nye, Receiver.	PP&FRy.	32	577	Oct.4 1901			
73										462	Same instrument as Parcel No. 61. Also covered by 2nd Instrument in Parcel No. 66.

LAND SCHEDULE FOR SHEET NO. 25.

114.4 Map 26(2)

Parcel No.	Custodian's No.	Kind of Instrument	Date of Instrument	Grantor	Grantee	Book	Page	Date	Acres	Square Feet	Remarks
~~42~~ ~~43~~ ~~44~~									~~16.88~~ ~~7.92~~	~~36475~~	~~3500 sq.ft. occupied by Henry St. 21600 sq.ft. occupied by Williams St. 11550 sq.ft. occupied by Williams St. Same instrument as Parcel No. 10. These Parcels leased to Fairport Warehouse and Elevator Co. for 999 years. Fairport Warehouse and Elevator Co. is 100% B&ORR.~~ See A.F.E.8519 (Pars. 43 & 44) See Note "B".
45	669	~~War. Deed~~	~~Apr.29 1898~~	~~A.E.Powers, Trst.~~	~~F.W. and Elev.Co.~~	~~28~~	~~545~~	~~Jul.1 1898~~	~~5.28~~		~~9900 sq.ft. occupied by Williams St.~~ 1.00Ac given to U.S. of A. 10-30-37. A.F.E. 24202 See Note "B".
46	670	Act of Congress	Dec.22 1906	R.S. Oliver, Sec. of War.	PP&FRy.	Office of Sec. of War. File No. 60501 13				8750	Lands used but not owned. Bridge across Grand River. Permit for construction of false work, and renewal of steel super-structure.
47 48	671	War. Deed	May 29 1916	The Fairport Land Co.	RE&ICo.	60	171	June 6 1916	49.924 2.753		Orig. Area Parcel No. 48=3.41Ac. 1.23 Ac. occupied by Fairport Road. Orig. Area of Par. No. 47=54.56Ac. Retired 1.867Ac. see cust. No. 693, A.F.E.=14978. This instrument does not warrant Par. No. 48. The F.P.&E.R.R. has easement across end of these Parcels. Add 0.546Ac. to Par. No. 47 due to adjustment of Property Line. Retire 0.218Ac. from Parcel No. 47 to form new Parcel No. 99. A.F.E.=45053 Retire 0.657Ac. from Parcel No. 48 to form new Parcel No. 100. A.F.E.=45053 Retired 3.097Ac. from Par. No. 47 see cust. No. 695. A.F.E.=45053
49	671	Q.C.Deed	May 29,16	Fairport Land Co.	RE&ICo.	56	321	June 6,16	2.443		Retired See cust. No. 695. A.F.E.=45053 Orig. Area=2.81Ac. Deleted 0.367Ac. due to error in Plotting.
50	642	Q.C.Deed	Oct.14,19	J.W.Blackburn, et ux	R.E.&I.Co.	66	182	Oct.22,19			
		Journal Entry	Sept.'24	Alek Oroszy vs	R.E.&I.Co.	79	12	Oct.21,24			Decree of Court placing title to this property in E.Oroszy. A.F.E. 9044.
		War.Deed	Apr.27,26	Elek Oroszy, et ux	B.&O.R.R.	107	410	Apr.28,26	0.455		
51	825	~~Agreement~~	~~May 22 1913~~	~~Fairport, Painesville and Eastern RR~~	~~B.&O.R.R.~~					~~1440~~	~~Agreement for construction of interchange track. Area based on arbitrary width of 10 ft.~~
	658	~~Agreement~~	~~Aug.16 1929~~	~~B.&O.R.R.~~	~~F.P.&E.R.R.~~						~~Track crossings.~~ Parcel deleted to form new Parcel No.101, A.F.E.45053
52	672	~~Q.C. Deed & Release~~	~~Jul.3 1908~~	~~H.Alvord, et ux.~~	~~PP&FRy.~~	~~44~~	~~286~~	~~Jul.14 1908~~		~~1160~~	Orig. Area=1800 sq.ft. ~~Conveys undivided 1/3 interest in Par. 52. Instrument also covers Parcels No.60, 61 and 62 (entire interest).~~ Deleted 640 sq.ft. due to error in Plotting. ~~This instrument reserves the use of a strip of land 20 ft. wide thru Parcel No. 52. The FP&ERR has easement across parcel No. 52.~~ See Note "A". Retired to form new Parcel No. 103. A.F.E.=45053

LAND SCHEDULE FOR SHEET No. 25.

Parcel No.	Custodian's No.	Kind of Instrument	Date of Instrument	Grantor	Grantee	Book	Page	Date	Acres	Square Feet	Remarks
88	652	War. Deed	June 2, 1926.	Adda H.Gray et vir	F.J.Jerome	107	644	June17 1926.		32,718	Original area=51,000 sq.ft. of which 18282 sq.ft. was sold to Light Alloys Co. Mar.22, 1927 Cust. No. 654.
	653	Q.C. Deed	Sept.20 1927.	F.J.Jerome et ux	Cleveland Trust Co.	137	166	Jan.19 1931.			Transfer of all land held in trust for B.&O.R.R. and N.Y.C.R.R.
	653	War. Deed	Feb. 6, 1931.	Cleveland Trust Co.	B.&O.R.R.	137	370	Mar.14 1931.			Instruments under Cust. No. 653 also cover Parcels 89 and 90. A.F.E. 9288.
89	651	War. Deed	Feb. 20, 1926.	J.F. McCashen et ux	F.J.Jerome	107	405	Apr. 26 1926.		107,700	Original area=176 723 sq.ft. of which 69,023 sq.ft. was sold to Light Alloys Co. Mar. 22 1927, Cust. No. 654. Also covered by instruments under Cust. No. 653 for Parcel 88. A.F.E. 9288.
90	655	War. Deed	May 10, 1927.	Light Alloys Co.	F.J.Jerome	111	420	July 12 1927.		18990	Original area=37,750 sq.ft. of which 18760 sq.ft. was conveyed to N.Y.C.R.R. Feb. 6 1931, Cust. No. 653 together with other lands held in trust. Also covered by instruments under Cust. No. 653 for Parcel 88. A.F.E. 9288.
91	601	War. Deed	June 20, 1929.	Ernestine Joughin et al	B.&O.R.R.	130	294	July 2, 1929.	0.140		A.F.E.=14978.
92	600	War. Deed	June 18, 1929.	John Wallie et ux.	B.&O.R.R.	129	373	June 20 1929.	0.357		Orig. Area=0.441 A.F.E.=14978. Retired 0.084Ac. See cust. No. 692 A.F.E.=
93									0.197		A.F.E.=14978 Orig. Area=0.210Ac. Record not found. Retired 0.013 Ac. See cust. No. 692 A.F.E.=
94	681	Easement Deed	Mar. 1, 1951	A.E. Staley Mfg. Co.	B.&O.R.R.	231	309	May 10, 1951	1.08		Perpetual easement for tracks. A.F.E. 59545.
95	687	War. Deed	Dec. 9, 1953	Diamond Alkali Co.	B.&O.R.R.	353	190	Jan. 26, 1954	0.434		Subject to a Roadway. A.F.E.=41138. Orig. Area=0.437 Ac. Retired 0.003Ac. to form new Parcel No. 106. A.F.E.=45053
~~96~~	~~688~~	~~Q.C. Deed~~	~~July 17, 1954~~	~~P.& L.E.D. Co.~~	~~B.&O.R.R.~~					1344	~~All rights, title & interest in a 8 ft. R/W Easement to the front & rear of Lot No. 262. A.F.E.=~~
97										2178	A.F.E.=
98	694	War. Deed	Mar. 12, 1956	Diamond Alkali Co.	B.&O.R.R.	408	246	Mar. 21, 1956	1.515		

Land Schedule Continued on Sheet No. 25, S-25C

REVISED TO		
Apr.	21	1923
June	28	1924
May	27	1925
Apr.	26	1926
Aug.	14	1926
Dec	31	1927
July	26	1928
Nov	23	1929
June	25	1931
Mar.	1	1946
Feb	5	1949
Apr.	10	1953
Dec.	2	1955
Jan.	3	1956
Jan.	7	1959
Apr.	13	1960

Sheet No. 26 of 25 primary and 16 supplemental sheets.

RIGHT-OF-WAY AND TRACK MAP

THE BALTIMORE AND OHIO RAILROAD COMPANY

OPERATED BY

THE BALTIMORE AND OHIO RAILROAD COMPANY

AKRON-CHICAGO DIVISION — FAIRPORT BRANCH

STATION 2640+00 TO STATION 2673+66

SCALE: 1 IN. = 200 FT. — JUNE 30, 1916.

OFFICE OF VALUATION ENGINEER
BALTIMORE, MD.

V-114.4
26