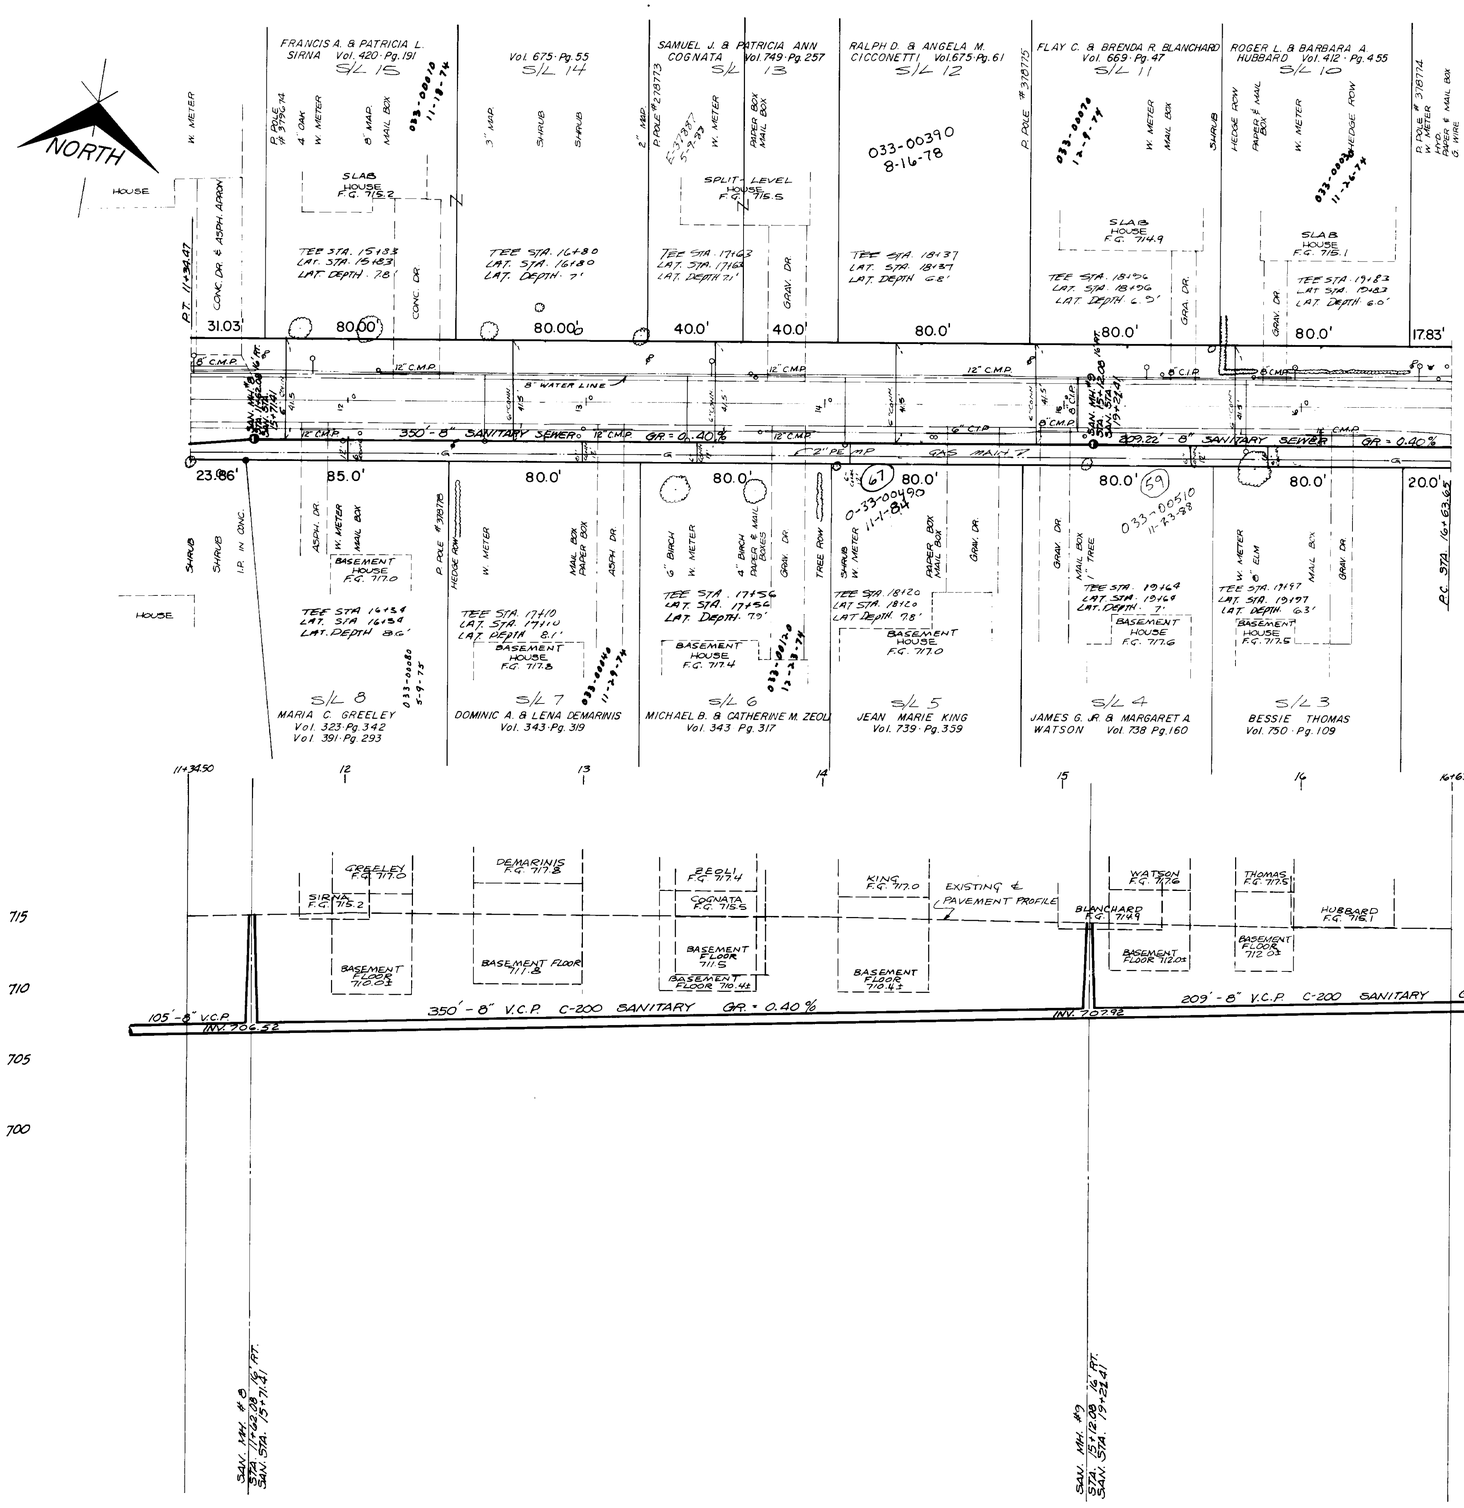

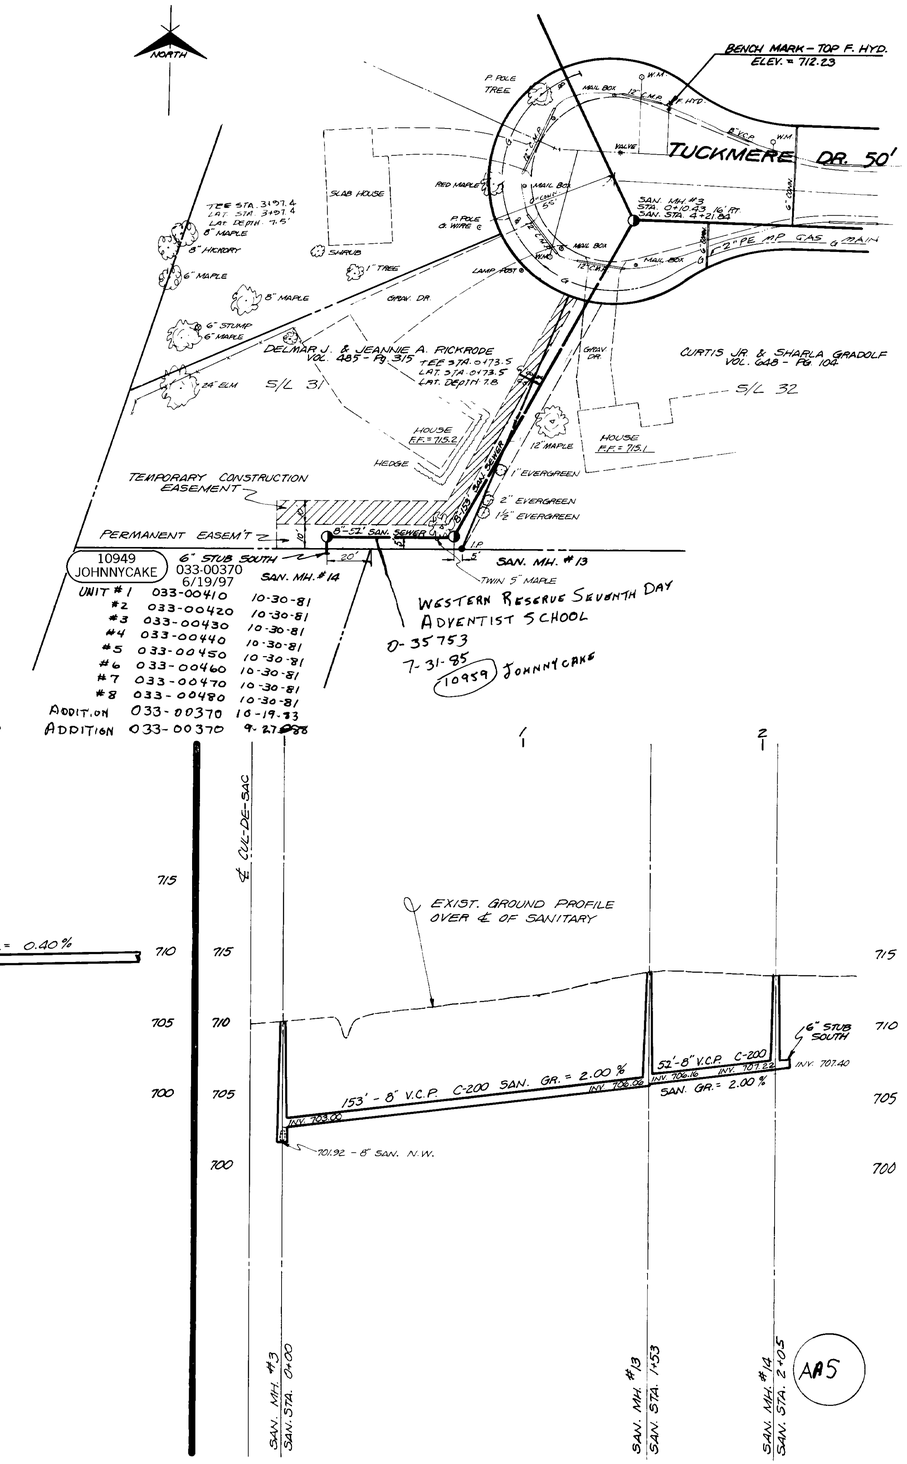

DEBEVEC, SALO & ASSOCIATES, INC.
CIVIL ENGINEERS SURVEYORS

TUCKMERE DRIVE · SEWAGE IMPROVEMENT · 83 S

PLAN & PROFILE
AS BUILT

AA5

4/5