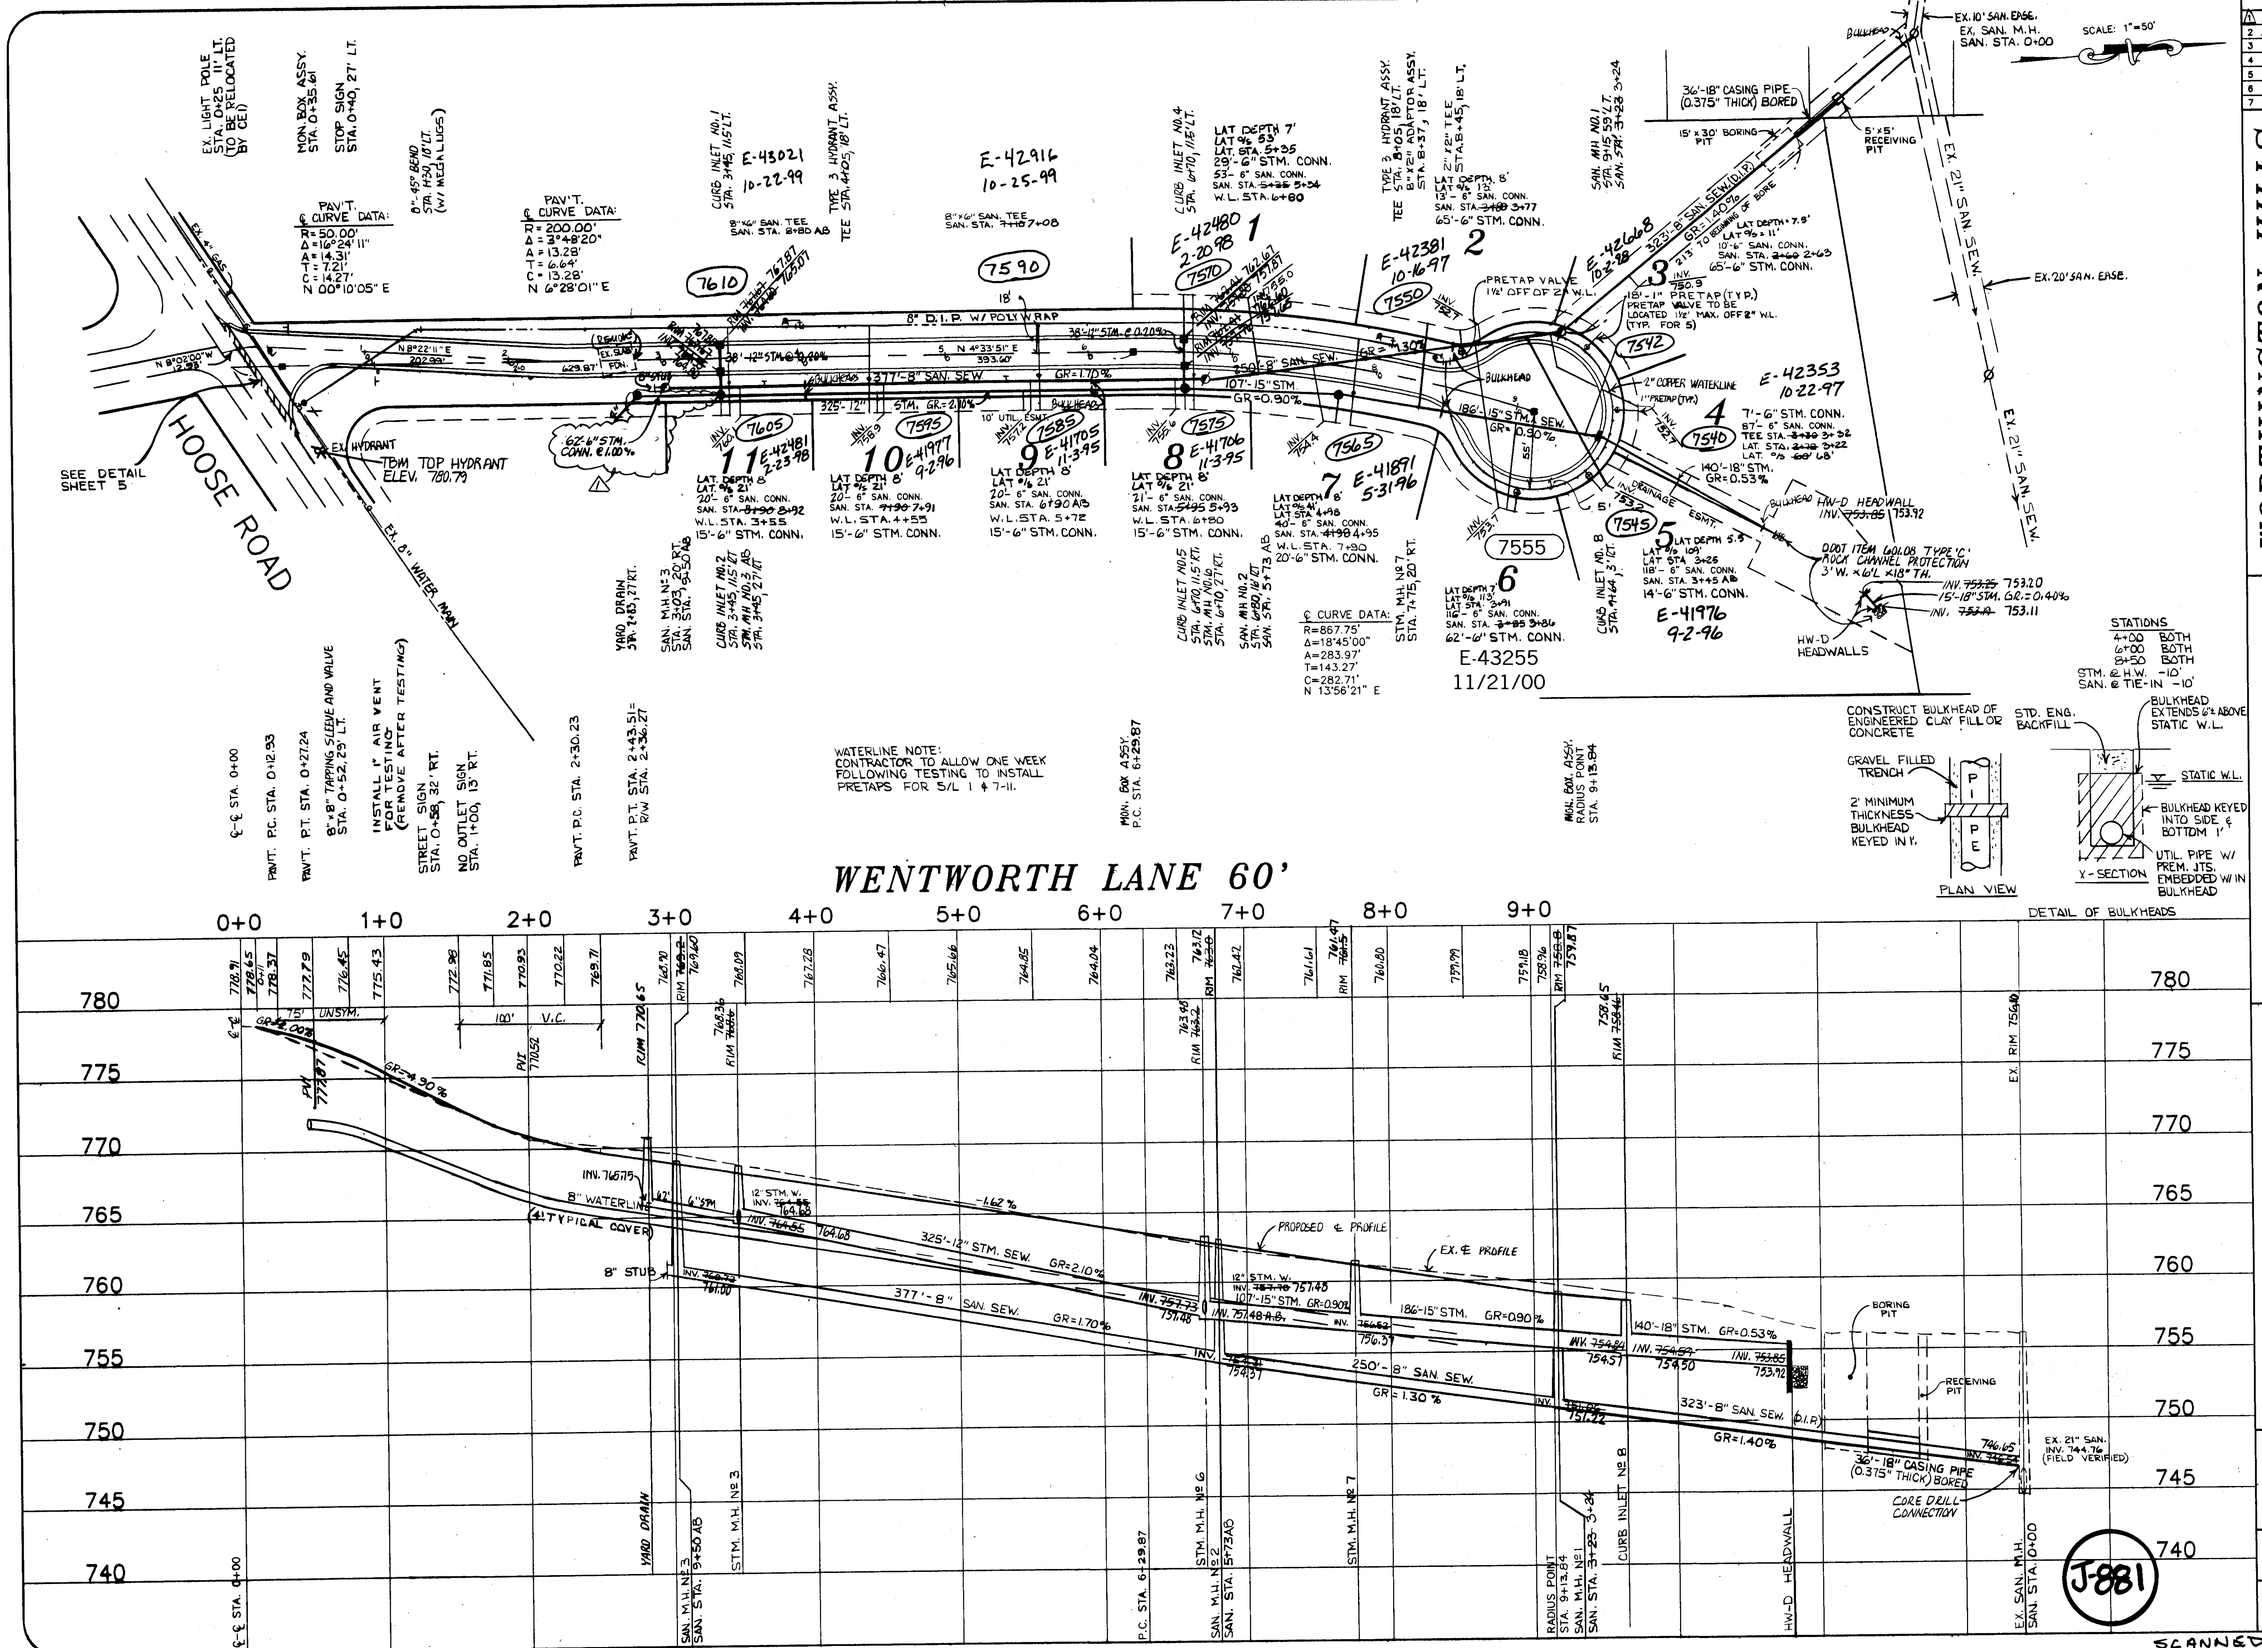

Revisions:
1 ADD STA. CONN. 9/5/95
2 AS-BUILT 10/27/95
3
4
5
6
7

WORTHINGTON HILLS SUBDIVISION

CONCORD TWP. – LAKE COUNTY – OHIO

GUTOSKEY & ASSOCIATES INC.
Civil Engineers and Surveyors
8227 E. Washington St. Tel 216-543-0600
Chagrin Falls, Ohio 44023 Fax 216-543-7170

PLAN & PROFILE WENTWORTH LANE

Date: JULY 1994
Scale: Hor. 1"=50' Vert. 1"=5'
Filename:
Checked By:
F.B. #:

Sheet 3 Of 7

CONTRACT No. 94-123

AS-BUILT