BURGESS & NIPLE — CONSULTING ENGINEERS — COLUMBUS, OHIO

LAKE COUNTY
SEWERAGE IMPROVEMENTS
WILLOUGHBY-MENTOR SEWER DISTRICT
OUTFALL

REVISIONS:

SCALE: 1" = 5' Vert. 1" = 50' Horz.	Drawn By / Checked By	Date: January 1962	Contract 0 / Sheet 2 of 4

USE FOR ALTERNATE "A"

REVISED 4-5-1966 AS CONSTRUCTED
THE INFORMATION SHOWN HEREON IS INTENDED TO BE COMPLETE AND CORRECT, HOWEVER, ALL PERSONS SHALL VERIFY INFORMATION TAKEN FROM THIS DRAWING.

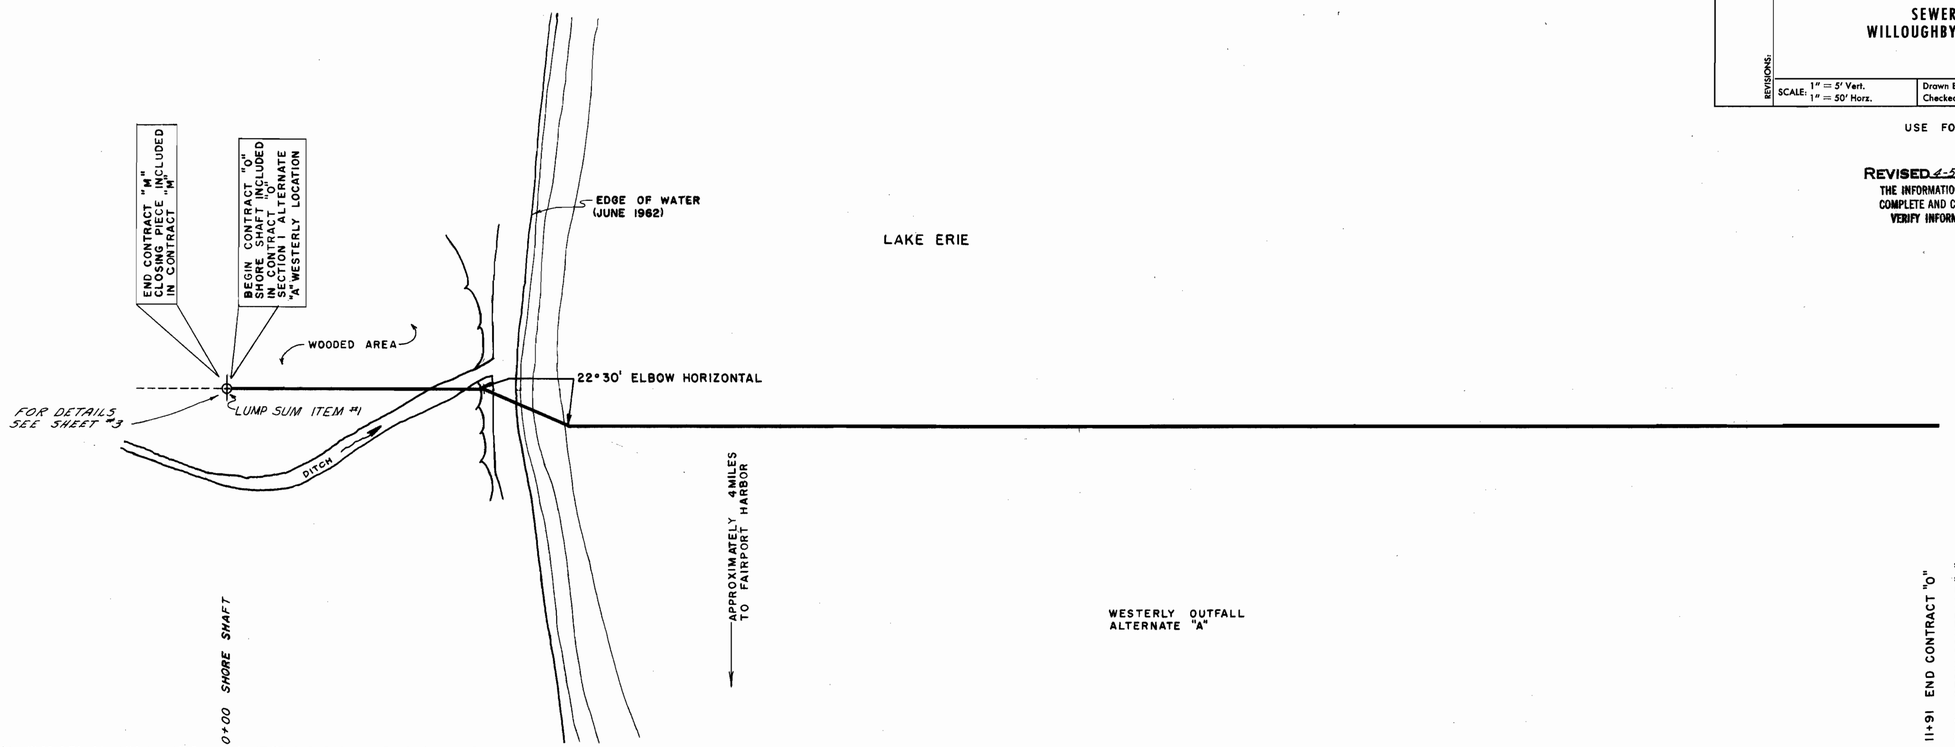

K-282

84-C