5878

5878

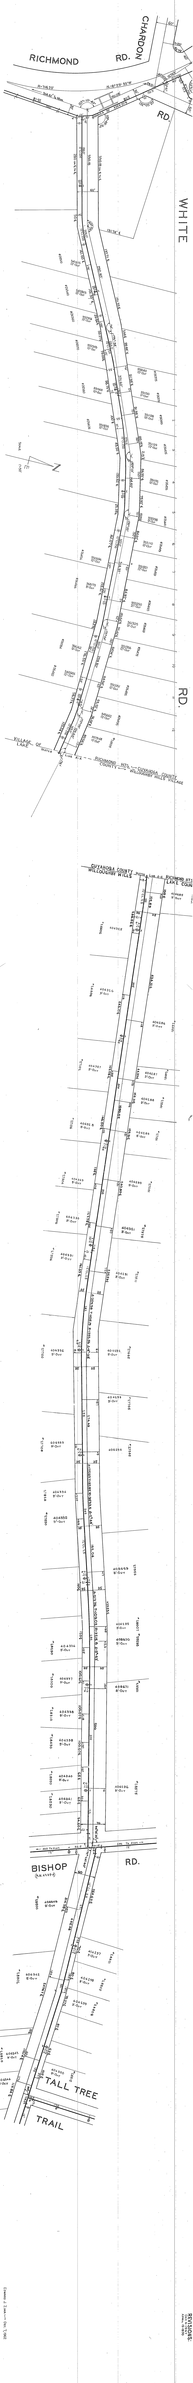

5878 E4

5878 E4